

NOTE:  
THE INFORMATION ON THIS PLAN IS COMPILED FROM VARIOUS SOURCES AND SHOULD BE VERIFIED PRIOR TO USE.  
LOCATIONS SHOWN ARE APPROXIMATE ONLY AND SHOULD BE VERIFIED IN THE FIELD PRIOR TO WORK COMMENCING.

Table of Revisions


M9			
Number	Revision	Date	By
0.	Revised	Oct. 2003	WR/JC
	Revised	June 2004	WR/JC
	Revised	June 2005	WR/JC
	Revised	June 2007	WR
	As-builts for P-1924	April 2011	MLR
	As-builts for S-1936	July 2012	MLR
	Added P-1956	Mar 2013	MLR
	Added P-1956 As-built	June 2015	MLR



The Corporation  
of the  
City of Windsor  
Engineering – Infrastructure & Geomatics



# SEWER ATLAS

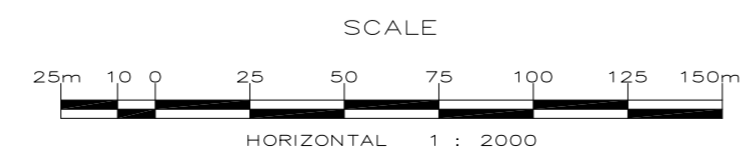

**Legend**

- SANITARY SEWER (Red dashed line)
- STORM SEWER (Blue dashed line)
- COMBINED SEWER (Green dashed line)
- PRIVATE SEWER (Purple dashed line)
- SANITARY PROPOSED OR AS BUILT INFO (Red solid line)
- STORM (Blue solid line)
- CULVERTS, CATCH BASINS AND OUTLETS (Star symbol)
- GAS LINE (Orange dashed line)
- STEAM LINE (Yellow dashed line)
- HYDRO ONE (Light blue dashed line)
- R.O.W. (Red dashed line)
- ASSESSMENT LOT (Yellow dashed line)
- HERB GRAY PKWY LIMITS (Green dashed line)

**Manhole Location**

- 700000 - Manhole Number
- N/A - North Invert
- 190.00 - South Invert
- 190.00 - East Invert
- 190.00 - West Invert
- 190.00 - Top Elevation

**Typical Dual Manhole**

- 700000 - Manhole Number
- N/A - North Invert
- 190.00 - South Invert
- 190.00 - East Invert
- 190.00 - West Invert
- 190.00 - Top Elevation

**Construction Details**

- 100.85m 1200mm CP (Pipe Length, Pipe Size, Pipe Material)
- S-1000 - CONSTRUCTION DWG NUMBER

L8	M8	N8
L9	<b>M9</b>	N9
L10	M10	N10