

NOTE:
 THE INFORMATION ON THIS PLAN IS COMPILED FROM VARIOUS SOURCES AND SHOULD BE VERIFIED PRIOR TO USE.
 LOCATIONS SHOWN ARE APPROXIMATE ONLY AND SHOULD BE VERIFIED IN THE FIELD PRIOR TO WORK COMMENCING.

Table of Revisions


Number	Revision	Date	By
0.	Revised	01-04-19	
	Revised	03-07-04	
	Revised	Oct. 2003	WR/JC
	Revised	June 2004	WR/JC
	Revised	June 2005	WR/JC
	Revised	June 2007	WR
	Added S-1623 As-built	Nov 2014	MLR
	Added S-1992 As-built	Jan 2016	MLR



The Corporation
 of the
 City of Windsor
 Engineering – Infrastructure & Geomatics



SEWER ATLAS

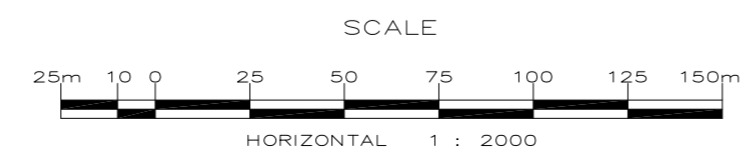

Legend

- SANITARY SEWER (Red dashed line)
- STORM SEWER (Blue dashed line)
- COMBINED SEWER (Green dashed line)
- PRIVATE SEWER (Black dashed line)
- SANITARY PROPOSED OR AS BUILT INFO (Red dashed line with 'P')
- STORM (Blue dashed line with 'S')
- GAS LINE (Yellow dashed line)
- STEAM LINE (Orange dashed line)
- HYDRO ONE (Purple dashed line)
- R.O.W (Black dashed line)
- ASSESSMENT LOT (Black dashed line)
- HERB GRAY PKWY LIMITS (Green dashed line)

Manhole Location

Type	Manhole Number	North Invert	South Invert	East Invert	West Invert	Top Elevation
S-Sanitary	7R0000	N/A	N/A	190.00	190.00	190.00
R-Storm	7R0000	N/A	N/A	190.00	190.00	190.00
C-Combined	7R0000	N/A	N/A	190.00	190.00	190.00

Typical Dual Manhole

Type	Manhole Number	North Invert	South Invert	East Invert	West Invert	Top Elevation
S-Sanitary	7R0000	N/A	N/A	190.00	190.00	190.00
R-Storm	7R0000	N/A	N/A	190.00	190.00	190.00

CONSTRUCTION DWG NUMBER
 [S-1000]

M5	N5	O5
M6	N6	O6
M7	N7	O7