

NOTE:  
THE INFORMATION ON THIS PLAN IS COMPILED FROM VARIOUS  
SOURCES, AND SHOULD BE VERIFIED PRIOR TO USE.

Table of Revisions


O14			
Number	Revision	Date	By
0.	Revised	01-04-19	
	Revised	03-07-04	
	Revised	Oct. 2003	WR/JC
	Revised	June 2004	WR/JC
	Revised	June 2005	WR/JC
	Revised	June 2007	WR
	Added P-1947 Proposed	Dec. 2009	MLR
	Added S-1877 As-Builts	Mar. 2010	MLR



The Corporation  
of the  
City of Windsor  
Public Works, Engineering & Projects



# SEWER ATLAS

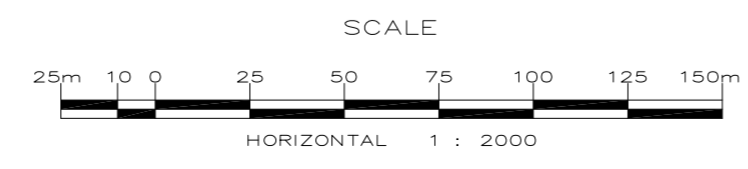

**Legend**

- SANITARY SEWER (Red dashed line)
- STORM SEWER (Blue dashed line)
- COMBINED SEWER (Green dashed line)
- SANITARY PROPOSED OR AS BUILT INFO N/A (Magenta dashed line)
- STORM ASSESSMENT LOT (Yellow dashed line)
- R.O.W. (Black dashed line)

**Manhole Location**

- 7R0000 - Manhole Number
- N/A - North Invert
- N/A - South Invert
- 190.00 - East Invert
- 190.00 - West Invert
- 190.00 - Top Elevation

**Typical Dual Manhole**

- 7S0000 - Manhole Number
- N/A - North Invert
- N/A - South Invert
- 190.00 - East Invert
- 190.00 - West Invert
- 190.00 - Top Elevation

**Construction Details**

- S-1000 - CONSTRUCTION DWG NUMBER
- 100.85m 120.0m CP - Pipe Length
- 100.85m 120.0m CP - Pipe Size
- 100.85m 120.0m CP - Pipe Material

N13	O13	P13
N14	<b>O14</b>	P14
N15	O15	P15