

NOTE:
 THE INFORMATION ON THIS PLAN IS COMPILED FROM VARIOUS SOURCES AND SHOULD BE VERIFIED PRIOR TO USE.
 LOCATIONS SHOWN ARE APPROXIMATE ONLY AND SHOULD BE VERIFIED IN THE FIELD PRIOR TO WORK COMMENCING.

Table of Revisions


Number	Revision	Date	By
	Revised	June 2004	WR/JC
	Revised	June 2005	WR/JC
	Revised	June 2007	WR
	Revised	Oct 2008	JM
	As-builts for S-1724	Dec 2009	MR
	As-builts for S-1839	Dec 2011	MR
	Added S-1992 Proposed	Dec 2014	MR
	Added S-1992 As-built	Jan 2016	MLR



The Corporation
 of the
 City of Windsor
 Engineering – Infrastructure & Geomatics



SEWER ATLAS

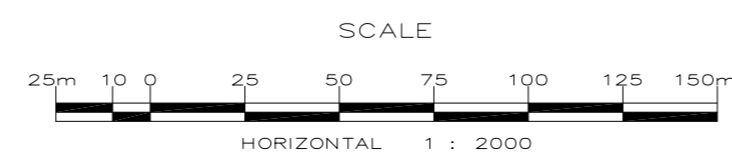

Legend

- SANITARY SEWER (Red dashed line)
- STORM SEWER (Blue dashed line)
- COMBINED SEWER (Green dashed line)
- PRIVATE SEWER (Purple dashed line)
- SANITARY PROPOSED OR AS BUILT INFO N/A (Red dashed line with 'P')
- STORM (Blue dashed line with 'S')
- GAS LINE (Red solid line)
- STEAM LINE (Blue solid line)
- HYDRO ONE (Red solid line)
- R.O.W (Blue solid line)
- ASSESSMENT LOT (Yellow shaded area)
- HERB GRAY PKWY LIMITS (Green dashed line)

Manhole Location

- 700000 - Manhole Number
- N/A - North Invert
- N/A - South Invert
- 190.00 - East Invert
- 190.00 - West Invert
- 190.00 - Top Elevation

Typical Dual Manhole

- 700000 - Manhole Number
- N/A - North Invert
- N/A - South Invert
- 190.00 - East Invert
- 190.00 - West Invert
- 190.00 - Top Elevation

Construction DWG Number

- S-1000

Other Symbols:

- Ward (Numbered square)
- Manhole Location (Circle with number)
- Pipe Length (Line with 'L')
- Pipe Size (Line with 'S')
- Pipe Material (Line with 'M')

N5	O5	P5
N6	O6	P6
N7	O7	P7