

NOTE:
THE INFORMATION ON THIS PLAN IS COMPILED FROM VARIOUS SOURCES AND SHOULD BE VERIFIED PRIOR TO USE.
LOCATIONS SHOWN ARE APPROXIMATE ONLY AND SHOULD BE VERIFIED IN THE FIELD PRIOR TO WORK COMMENCING.

Table of Revisions


Number	Revision	Date	By
0.	Revised	03-07-04	
	Revised	Oct. 2003	WR/JC
	Revised	June 2004	WR/JC
	Revised	June 2005	WR/JC
	Revised	June 2007	WR
	Added S-1885 As-built	Feb. 2013	MLR
	Added S-1851 As-built	July 2013	MLR
	Added S-1992 As-built	Jan. 2016	MLR



The Corporation
of the
City of Windsor
Engineering – Infrastructure & Geomatics



SEWER ATLAS

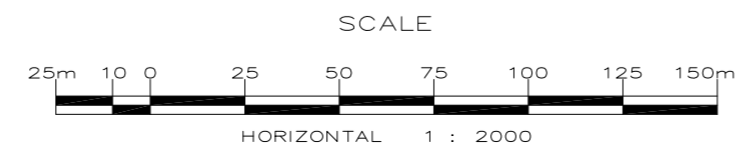

--- SANITARY SEWER
--- STORM SEWER
--- COMBINED SEWER
--- PRIVATE SEWER
--- SANITARY PROPOSED OR AS BUILT INFO N/A
--- STORM
--- GAS LINE
--- STEAM LINE
--- HYDRO ONE
--- R.O.W.
--- ASSESSMENT LOT
--- HERB GRAY PKWY LIMITS

Type
 S-Sanitary
 R-Storm
 C-Combined
 Manhole Location
 700000 Manhole Number
 N/A North Invert
 N/A South Invert
 190.00 East Invert
 190.00 West Invert
 190.00 Top Elevation

Type
 Typical Dual Manhole
 700000 Manhole Number
 N/A North Invert
 N/A South Invert
 190.00 East Invert
 190.00 West Invert
 190.00 Top Elevation

Pipe Length
 100.85m 1200mm CP
 47.41m 250mm AC
 63.13m 300mm CP
 47.41m 250mm AC
 63.13m 300mm CP

Construction Drawing Number
 [S-1000]

N6	O6	P6
N7	O7	P7
N8	O8	P8