

NOTE:  
THE INFORMATION ON THIS PLAN IS COMPILED FROM VARIOUS  
SOURCES, AND SHOULD BE VERIFIED PRIOR TO USE.

Table of Revisions


| P13    |                       |           |       |  |
|--------|-----------------------|-----------|-------|--|
| Number | Revision              | Date      | By    |  |
| 0.     | Revised               | 01-04-19  |       |  |
|        | Revised               | 03-07-04  |       |  |
|        | Revised               | Oct. 2003 | WR/JC |  |
|        | Revised               | June 2004 | WR/JC |  |
|        | Revised               | June 2005 | WR/JC |  |
|        | Revised               | June 2007 | WR    |  |
|        | Added S-1886 Proposed | Dec. 2009 | MLR   |  |
|        | S-1886 As-built       | Mar. 2011 | MLR   |  |



The Corporation  
of the  
City of Windsor  
Public Works, Engineering & Projects



# SEWER ATLAS

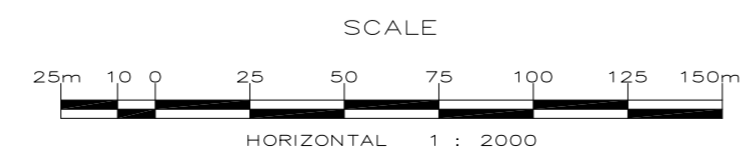

|   |   |   |
|---|---|---|
| <ul style="list-style-type: none"> <li>--- SANITARY SEWER</li> <li>--- STORM SEWER</li> <li>--- COMBINED SEWER</li> <li>--- SANITARY PROPOSED OR AS BUILT INFO N/A</li> <li>--- STORM ASSESSMENT LOT</li> <li>--- R.O.W.</li> <li>--- S-1000 CONSTRUCTION DWG NUMBER</li> </ul> | <p>Ward</p> <ul style="list-style-type: none"> <li>S-Sanitary</li> <li>R-Storm</li> <li>C-Combined</li> </ul> <p>Manhole Location</p> <ul style="list-style-type: none"> <li>700000 Manhole Number</li> <li>N/A North Invert</li> <li>N/A South Invert</li> <li>190.00 East Invert</li> <li>190.00 West Invert</li> <li>190.00 Top Elevation</li> </ul> <p>100.85m 1200mm CP</p> <p>Pipe Length Pipe Size Pipe Material</p> | <p>Ward</p> <ul style="list-style-type: none"> <li>700000 Manhole Number</li> <li>N/A North Invert</li> <li>N/A South Invert</li> <li>190.00 East Invert</li> <li>190.00 West Invert</li> <li>190.00 Top Elevation</li> </ul> <p>Typical Dual Manhole</p> <ul style="list-style-type: none"> <li>Storm</li> <li>Sanitary</li> </ul> |
|---|---|---|

|     |            |     |
|-----|------------|-----|
| 012 | P12        | Q12 |
| 013 | <b>P13</b> | Q13 |
| 014 | P14        | Q14 |