

NOTE:
 THE INFORMATION ON THIS PLAN IS COMPILED FROM VARIOUS SOURCES AND SHOULD BE VERIFIED PRIOR TO USE.
 LOCATIONS SHOWN ARE APPROXIMATE ONLY AND SHOULD BE VERIFIED IN THE FIELD PRIOR TO WORK COMMENCING.

Table of Revisions


P15			
Number	Revision	Date	By
0.	Revised	01-04-19	
	Revised	03-07-04	
	Revised	Oct. 2003	WR/JC
	Revised	June 2004	WR/JC
	Revised	June 2005	WR/JC
	Revised	June 2007	WR
	Added S-1886 & S-1909 Proposed	Dec. 2009	MLR
	S-1886 As-built	Mar. 2011	MLR



The Corporation
 of the
 City of Windsor
 Engineering – Infrastructure & Geomatics



SEWER ATLAS

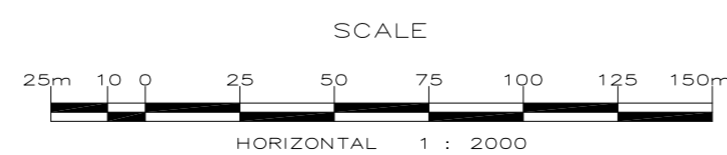

<ul style="list-style-type: none"> — SANITARY SEWER — STORM SEWER — COMBINED SEWER — PRIVATE SEWER — SANITARY PROPOSED OR AS BUILT INFO N/A — STORM — GAS LINE — STEAM LINE — HYDRO ONE — R.O.W. — ASSESSMENT LOT — HERB GRAY PKWY LIMITS 	<p>Manhole Location</p> <ul style="list-style-type: none"> 700000 — Manhole Number N/A — North Invert N/A — South Invert 190.00 — East Invert 190.00 — West Invert 190.00 — Top Elevation <p>100.85m 1200mm CP</p> <p>Pipe Length Pipe Size Pipe Material</p>	<p>Manhole Location</p> <ul style="list-style-type: none"> 700000 — Manhole Number N/A — North Invert N/A — South Invert 190.00 — East Invert 190.00 — West Invert 190.00 — Top Elevation <p>Storm Sanitary</p> <p>— [S-1000] — CONSTRUCTION DWG NUMBER</p>
---	---	---

014	P14	Q14
015	P15	Q15
016	P16	Q16