

NOTE:
THE INFORMATION ON THIS PLAN IS COMPILED FROM VARIOUS SOURCES AND SHOULD BE VERIFIED PRIOR TO USE.
LOCATIONS SHOWN ARE APPROXIMATE ONLY AND SHOULD BE VERIFIED IN THE FIELD PRIOR TO WORK COMMENCING.

Table of Revisions


Number	Revision	Date	By
0.	Revised	June 2005	WR/JC
	Revised	June 2007	WR
	Revised	Oct 2008	JM
	Added Virginia Ave Sewers to Proposed Layer	Dec 2008	JM
	Added S-1947 Proposed	Jan 2013	MLR
	Added S-1927	Aug 2013	MLR
	Added S-1947 As Built	Mar 2016	MLR
	Added S-1971 As Built	July 2016	MLR



The Corporation
of the
City of Windsor
Engineering – Infrastructure & Geomatics



SEWER ATLAS

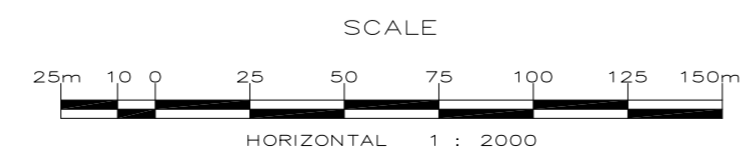

<ul style="list-style-type: none"> — SANITARY SEWER — STORM SEWER — COMBINED SEWER — PRIVATE SEWER — SANITARY PROPOSED OR AS BUILT INFO N/A — STORM — GAS LINE — STEAM LINE — HYDRO ONE — R.O.W — ASSESSMENT LOT — HERB GRAY PKWY LIMITS 	<p>Manhole Location</p> <p>700000 Manhole Number</p> <ul style="list-style-type: none"> North Invert N/A South Invert N/A East Invert 190.00 West Invert 190.00 Top Elevation 	<p>Manhole Location</p> <p>700000 Manhole Number</p> <ul style="list-style-type: none"> North Invert N/A South Invert N/A East Invert 190.00 West Invert 190.00 Top Elevation
--	--	--

Ward: 700000

Typical Dual Manhole

— [S-1000] CONSTRUCTION DWG NUMBER

01	P1	Q1
02	P2	Q2
03	P3	Q3