


NOTE:
 THE INFORMATION ON THIS PLAN IS COMPILED FROM VARIOUS SOURCES AND SHOULD BE VERIFIED PRIOR TO USE.
 LOCATIONS SHOWN ARE APPROXIMATE ONLY AND SHOULD BE VERIFIED IN THE FIELD PRIOR TO WORK COMMENCING.

Table of Revisions

Q12			
Number	Revision	Date	By
0.	Revised	Sept/2003	
	Revised	Oct. 2003	WR/JC
	Revised	June 2004	WR/JC
	Revised	June 2005	WR/JC
	Revised	June 2007	WR
	Added S-1884 As-built	June 2011	MLR

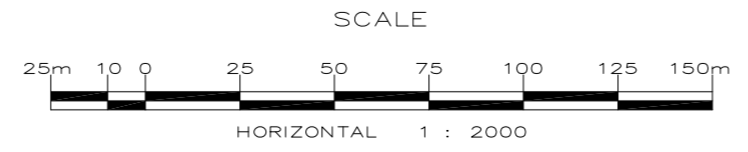

Legend

- SANITARY SEWER (Red dashed line)
- STORM SEWER (Blue dashed line)
- COMBINED SEWER (Green dashed line)
- PRIVATE SEWER (Purple dashed line)
- SANITARY AS BUILT INFO N/A (Red dashed line with dots)
- STORM AS BUILT INFO N/A (Blue dashed line with dots)
- CULVERTS, CATCH BASINS AND OUTLETS (Black dashed line with triangles)
- GAS LINE (Orange dashed line)
- STEAM LINE (Black dashed line with circles)
- HYDRO ONE (Black dashed line with squares)
- R.O.W (Black dashed line)
- ASSESSMENT LOT (Black solid line)
- HERB GRAY PKWY LIMITS (Black dashed line)

Manhole Location

- 7R0000 - Manhole Number
- N/A - North Invert
- 190.00 - South Invert
- 190.00 - East Invert
- 190.00 - West Invert
- 190.00 - Top Elevation

Typical Dual Manhole

- 7R0000 - Manhole Number
- N/A - North Invert
- 190.00 - South Invert
- 190.00 - East Invert
- 190.00 - West Invert
- 190.00 - Top Elevation

Sanitary

- S-1000 - CONSTRUCTION DWG NUMBER

Other Symbols

- Ward
- Manhole Location
- Pipe Length
- Pipe Size
- Pipe Material

P11	Q11	R11
P12	Q12	R12
P13	Q13	R13