

NOTE:
THE INFORMATION ON THIS PLAN IS COMPILED FROM VARIOUS SOURCES AND SHOULD BE VERIFIED PRIOR TO USE.
LOCATIONS SHOWN ARE APPROXIMATE ONLY AND SHOULD BE VERIFIED IN THE FIELD PRIOR TO WORK COMMENCING.

Table of Revisions


R3			
Number	Revision	Date	By
Revised		June 2005	WR/JC
Revised		July 2007	WR
Revised To Show Edge of Pavement		July 2007	WR
Added S-1882		Nov. 2009	MLR
Added S-1894 Proposed		Apr 2010	MLR
Added S-1882 & S-1894 As-Built		Jan 2011	MLR
Added S-1978 & S-2007 Proposed		May 2015	MLR
Added S-2012 As-Built		July 2016	MLR



The Corporation
of the
City of Windsor
Engineering – Infrastructure & Geomatics



SEWER ATLAS

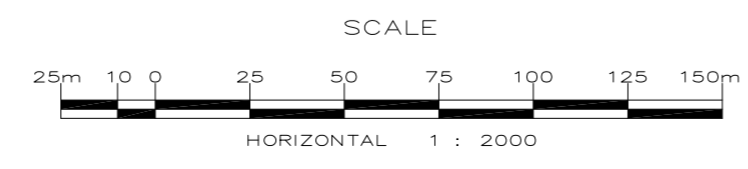

<ul style="list-style-type: none"> Sanitary Sewer Storm Sewer Combined Sewer Private Sewer Sanitary Proposed or As-Built Info Storm Proposed or As-Built Info Gas Line Steam Line Hydro One R.O.W. Assessment Lot Herb Gray Pkwy Limits 	<ul style="list-style-type: none"> Manhole Number: 7R0000 North Invert: N/A South Invert: N/A East Invert: 190.00 West Invert: 190.00 Top Elevation: 190.00 	<ul style="list-style-type: none"> Manhole Number: 7S0000 North Invert: N/A South Invert: N/A East Invert: 190.00 West Invert: 190.00 Top Elevation: 190.00
---	---	---

Type: S-Sanitary, R-Storm, C-Combined
 Manhole Location: 100.85m, 1200mm CP
 Pipe Length: Pipe Size, Pipe Material
 Construction DWG Number: [S-1000]

Q2	R2	S2
Q3	R3	S3
Q4	R4	S4