

NOTE:  
THE INFORMATION ON THIS PLAN IS COMPILED FROM VARIOUS SOURCES AND SHOULD BE VERIFIED PRIOR TO USE.  
LOCATIONS SHOWN ARE APPROXIMATE ONLY AND SHOULD BE VERIFIED IN THE FIELD PRIOR TO WORK COMMENCING.

Table of Revisions


R4			
Number	Revision	Date	By
	Added Proposed Sewer for McHugh Ext (P-1921)	May 2008	JC
	Added S-1874 & S-1875 Proposed	Sep 2009	MLR
	Added S-1882 Proposed	Nov 2009	MLR
	S-1874 As-built	June 2010	MLR
	Added S-1882 As-built	Jan 2011	MLR
	Added S-1759 As-built	May 2011	MLR
	Added S-1920 As-built	Nov 2011	MLR
	Added S-1943 As-built	Feb 2013	MLR
	Added S-2012 As-built	July 2016	MLR



The Corporation  
of the  
City of Windsor  
Engineering – Infrastructure & Geomatics



# SEWER ATLAS

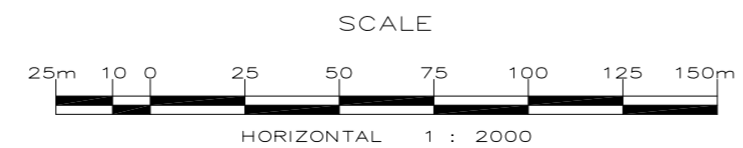

**Legend**

- SANITARY SEWER (Red dashed line)
- STORM SEWER (Blue dashed line)
- COMBINED SEWER (Green dashed line)
- PRIVATE SEWER (Purple dashed line)
- SANITARY PROPOSED OR AS BUILT INFO N/A (Red dashed line with 'P')
- STORM (Blue dashed line with 'S')
- GAS LINE (Red solid line)
- STEAM LINE (Red solid line with 'S')
- HYDRO ONE (Red solid line with 'H')
- R.O.W (Red solid line)
- ASSESSMENT LOT (Black outline)
- HERB GRAY PKWY LIMITS (Yellow dashed line)

**Manhole Location**

Type: S-Sanitary, R-Storm, C-Combined

7R0000 - Manhole Number  
N/A - North Invert  
S - South Invert  
E - East Invert  
W - West Invert  
190.00 - Top Elevation

**Typical Dual Manhole**

Type: S-Sanitary, R-Storm

7R0000 - Manhole Number  
N/A - North Invert  
S - South Invert  
E - East Invert  
W - West Invert  
190.00 - Top Elevation

100.85m 1200mm CP  
Pipe Length Pipe Size Pipe Material

[S-1000] - CONSTRUCTION DWG NUMBER

Q3	R3	S3
Q4	R4	S4
Q5	R5	S5