

NOTE:
THE INFORMATION ON THIS PLAN IS COMPILED FROM VARIOUS SOURCES AND SHOULD BE VERIFIED PRIOR TO USE.
LOCATIONS SHOWN ARE APPROXIMATE ONLY AND SHOULD BE VERIFIED IN THE FIELD PRIOR TO WORK COMMENCING.

Table of Revisions


Number	Revision	Date	By
0.	Revised	Sept./2003	WR/JC
	Revised	Oct. 2003	WR/JC
	Revised	June 2004	WR/JC
	Revised	June 2005	WR/JC
	Revised	July 2007	WR
	Revised To Show Edge of Pavement 2006	June 2007	WR
	As-builts for S-1876 - Ruth Rd	Jan 2010	MLR



The Corporation
of the
City of Windsor
Engineering – Infrastructure & Geomatics



SEWER ATLAS

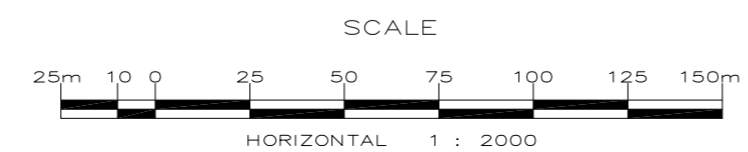

Legend

- SANITARY SEWER (Red dashed line)
- STORM SEWER (Blue dashed line)
- COMBINED SEWER (Green dashed line)
- PRIVATE SEWER (Purple dashed line)
- SANITARY PROPOSED OR AS BUILT INFO N/A (Red dashed line with 'N/A' label)
- STORM (Blue dashed line with 'N/A' label)
- GAS LINE (Red solid line)
- STEAM LINE (Blue solid line)
- HYDRO ONE (Red solid line)
- R.O.W. (Red solid line)
- ASSESSMENT LOT (Black outline)
- HERB GRAY PKWY LIMITS (Yellow dashed line)

Manhole Location

- 780000 - Manhole Number
- 190.00 - North Invert
- 190.00 - South Invert
- 190.00 - East Invert
- 190.00 - West Invert
- 190.00 - Top Elevation

Typical Dual Manhole

- 780000 - Manhole Number
- N/A - North Invert
- N/A - South Invert
- 190.00 - East Invert
- 190.00 - West Invert
- 190.00 - Top Elevation

Construction Drawing Number

- S-1000 - CONSTRUCTION DWG NUMBER

Q5	R5	S5
Q6	R6	S6
Q7	R7	S7