




NOTE:
 THE INFORMATION ON THIS PLAN IS COMPILED FROM VARIOUS SOURCES AND SHOULD BE VERIFIED PRIOR TO USE.
 LOCATIONS SHOWN ARE APPROXIMATE ONLY AND SHOULD BE VERIFIED IN THE FIELD PRIOR TO WORK COMMENCING.

Table of Revisions



S11			
Number	Revision	Date	By
0.	Revised	Sept/2003	
	Revised	Oct. 2003	WR/JC
	Revised	June 2004	WR/JC
	Revised	June 2005	WR/JC
	Revised	June 2007	WR
	Added S-1888 - Proposed	Dec 2009	MLR
	Added S-1888 As-built	July 2011	MLR



The Corporation
 of the
 City of Windsor
 Engineering – Infrastructure & Geomatics

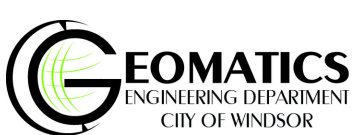

SEWER ATLAS

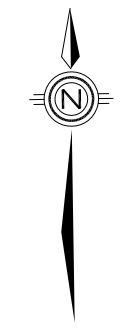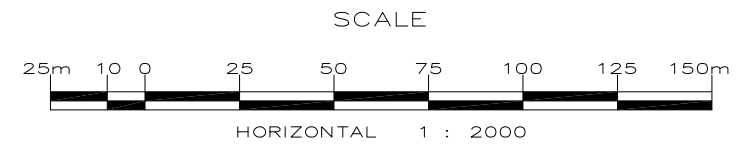

Legend for Sewer Atlas:

- SANITARY SEWER (Blue line)
- STORM SEWER (Green line)
- COMBINED SEWER (Red line)
- PRIVATE SEWER (Purple line)
- SANITARY PROPOSED OR AS BUILT INFO N/A (Dashed blue line)
- STORM PROPOSED OR AS BUILT INFO N/A (Dashed green line)
- CULVERTS, CATCH BASINS AND OUTLETS (Star symbol)
- GAS LINE (Orange line)
- STEAM LINE (Yellow line)
- HYDRO ONE (Light blue line)
- R.O.W. (Red dashed line)
- ASSESSMENT LOT (Black outline)
- HERB GRAY PKWY LIMITS (Yellow dashed line)

Manhole Location Legend:

- Type: S=Sanitary, R=Storm, C=Combined
- Manhole Number: 7R0000
- North Invert: N/A
- South Invert: N/A
- East Invert: 190.00
- West Invert: 190.00
- Top Elevation: 190.00
- Sanitary: S=1000 CONSTRUCTION DWG NUMBER

Other symbols: Pipe Length, Pipe Size, Pipe Material, Herb Gray Pkwy Limits.

R10	S10	T10
R11	S11	T11
R12	S12	T12