

NOTE:  
THE INFORMATION ON THIS PLAN IS COMPILED FROM VARIOUS SOURCES AND SHOULD BE VERIFIED PRIOR TO USE.  
LOCATIONS SHOWN ARE APPROXIMATE ONLY AND SHOULD BE VERIFIED IN THE FIELD PRIOR TO WORK COMMENCING.

Table of Revisions


Number	Revision	Date	By
0.	Revised	June 2004	WR/JC
	Revised	June 2005	WR/JC
	Revised	June 2007	WR
	Revised To Show Edge of Pavement 2006	July 2007	WR
	Added S-1935 As-built	June 2013	MLR
	Added S-1985 As-built	Dec. 2014	MLR
	Added S-1978 & S-2007 Proposed	May 2015	MLR
	Added S-2007 As-built	Jan. 2016	MLR



The Corporation  
of the  
City of Windsor  
Engineering – Infrastructure & Geomatics



# SEWER ATLAS

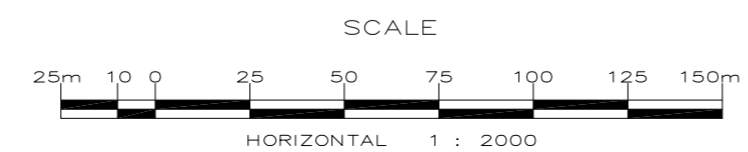

**Legend**

- SANITARY SEWER (Red dashed line)
- STORM SEWER (Blue dashed line)
- COMBINED SEWER (Green dashed line)
- PRIVATE SEWER (Black dashed line)
- SANITARY PROPOSED OR AS BUILT INFO N/A (Red dashed line with 'P')
- STORM (Blue dashed line with 'S')
- GAS LINE (Yellow dashed line)
- STEAM LINE (Orange dashed line)
- HYDRO ONE (Light blue dashed line)
- R.O.W. (Red dashed line)
- ASSESSMENT LOT (Black dashed line)
- HERB GRAY PKWY LIMITS (Black dashed line)

**Manhole Location**

- Manhole Number: 750000
- North Invert: N/A
- South Invert: N/A
- East Invert: 190.00
- West Invert: 190.00
- Top Elevation: 190.00

**Construction DWG Number**

- Typical Dual Manhole: S-1000

R2	S2	T2
R3	<b>S3</b>	T3
R4	S4	T4