

NOTE:
THE INFORMATION ON THIS PLAN IS COMPILED FROM VARIOUS SOURCES AND SHOULD BE VERIFIED PRIOR TO USE.
LOCATIONS SHOWN ARE APPROXIMATE ONLY AND SHOULD BE VERIFIED IN THE FIELD PRIOR TO WORK COMMENCING.

Table of Revisions


Number	Revision	Date	By
0.	Revised	Oct. 2003	WR/JC
	Revised	June 2004	WR/JC
	Revised	June 2005	WR/JC
	Revised	June 2007	WR
	Revised To Show Edge of Pavement 2006	July 2007	WR
	As-builts for Katella Ave.	Nov 2007	MR
	As-builts for Luxury Ave. & Sturgeson St.	Dec 2007	MR
	Added S-1985 As-built	Dec. 2014	MLR



The Corporation
of the
City of Windsor
Engineering – Infrastructure & Geomatics



SEWER ATLAS

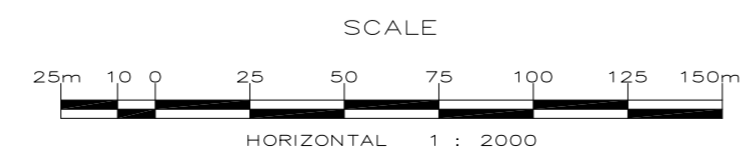

Legend

- SANITARY SEWER (Blue dashed line)
- STORM SEWER (Green dashed line)
- COMBINED SEWER (Red dashed line)
- PRIVATE SEWER (Purple dashed line)
- SANITARY PROPOSED OR AS BUILT INFO (Blue solid line)
- STORM (Green solid line)
- GAS LINE (Red solid line)
- STEAM LINE (Purple solid line)
- HYDRO ONE (Blue solid line)
- R.O.W. (Red solid line)
- ASSESSMENT LOT (Black outline)
- HERB GRAY PKWY LIMITS (Yellow dashed line)

Manhole Location

- Manhole Number: 780000
- North Invert: N/A
- South Invert: N/A
- East Invert: 190.00
- West Invert: 190.00
- Top Elevation: 190.00

Typical Dual Manhole

- Manhole Number: 780000
- North Invert: N/A
- South Invert: N/A
- East Invert: 190.00
- West Invert: 190.00
- Top Elevation: 190.00

Construction DWG Number: S-1000

R3	S3	T3
R4	S4	T4
R5	S5	T5