

NOTE:
THE INFORMATION ON THIS PLAN IS COMPILED FROM VARIOUS SOURCES AND SHOULD BE VERIFIED PRIOR TO USE.
LOCATIONS SHOWN ARE APPROXIMATE ONLY AND SHOULD BE VERIFIED IN THE FIELD PRIOR TO WORK COMMENCING.

Table of Revisions



Number	Revision	Date	By
0.	Revised		
	Revised	Sept./2003	WR/JC
	Revised	Oct. 2003	WR/JC
	Revised	June 2004	WR/JC
	Revised	June 2005	WR/JC
	Revised	June 2007	WR
	Revised To Show Edge of Pavement 2006	July 2007	WR
	Springhollow as-builts	Jan 2008	PJU
	Trunk Sanitary Sewer as-builts for Annexed Lands along CNR	Jan 2008	MLR



The Corporation
of the
City of Windsor
Engineering – Infrastructure & Geomatics



SEWER ATLAS

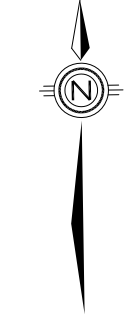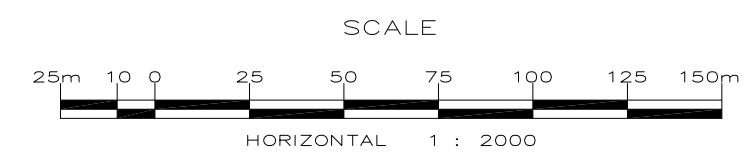

Legend

- SANITARY SEWER (Red dashed line)
- STORM SEWER (Blue dashed line)
- COMBINED SEWER (Green dashed line)
- PRIVATE SEWER (Purple dashed line)
- SANITARY PROPOSED OR AS BUILT INFO (Red solid line)
- STORM (Blue solid line)
- GAS LINE (Yellow dashed line)
- STEAM LINE (Orange dashed line)
- HYDRO ONE (Light blue dashed line)
- R.O.W. (Red solid line)
- ASSESSMENT LOT (Black outline)
- HERB GRAY PKWY LIMITS (Green dashed line)

Manhole Location

- 780000 - Manhole Number
- North Invert
- South Invert
- East Invert
- West Invert
- Top Elevation

Typical Dual Manhole

- 780000 - Manhole Number
- North Invert
- South Invert
- East Invert
- West Invert
- Top Elevation

Construction Drawing Number

- [S-1000] - CONSTRUCTION DWG NUMBER

R4	S4	T4
R5	S5	T5
R6	S6	T6