


NOTE:  
THE INFORMATION ON THIS PLAN IS COMPILED FROM VARIOUS SOURCES AND SHOULD BE VERIFIED PRIOR TO USE.  
LOCATIONS SHOWN ARE APPROXIMATE ONLY AND SHOULD BE VERIFIED IN THE FIELD PRIOR TO WORK COMMENCING.

Table of Revisions



S8			
Number	Revision	Date	By
0.	Revised	Sept/2003	
	Revised	Oct. 2003	WR/JC
	Revised	June 2004	WR/JC
	Revised	June 2005	WR/JC
	Revised	June 2007	WR
	Added S-1944	Feb 2013	MLR
	Added S-1944 As-Built	Sep 2015	MLR



The Corporation of the City of Windsor  
Engineering – Infrastructure & Geomatics

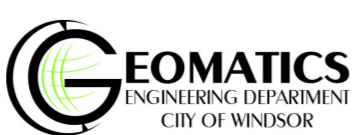

# SEWER ATLAS

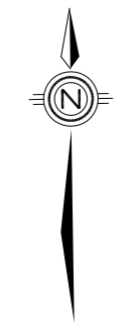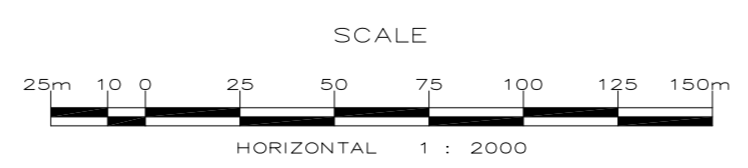

Legend for Sewer Atlas:

- SANITARY SEWER (Red dashed line)
- STORM SEWER (Blue dashed line)
- COMBINED SEWER (Green dashed line)
- PRIVATE SEWER (Purple dashed line)
- SANITARY PROPOSED OR AS BUILT INFO N/A (Red solid line)
- STORM PROPOSED OR AS BUILT INFO N/A (Blue solid line)
- CULVERTS, CATCH BASINS AND OUTLETS (Black solid line)
- GAS LINE (Orange solid line)
- STEAM LINE (Yellow solid line)
- HYDRO ONE (Light blue solid line)
- R.O.W. (Black solid line)
- ASSESSMENT LOT (Black solid line)
- HERB GRAY PKWY LIMITS (Black dashed line)

Manhole Symbols:

- Type: S=Sanitary, R=Storm, C=Combined
- Manhole Number: 7R0000
- Location: North Invert, South Invert, East Invert, West Invert, Top Elevation
- Typical Dual Manhole: 7R0000
- Manhole Number: N/A
- Location: North Invert, South Invert, East Invert, West Invert, Top Elevation

Construction Drawing Number: S-1000

R7	S7	T7
R8	<b>S8</b>	T8
R9	S9	T9