

NOTE:
 THE INFORMATION ON THIS PLAN IS COMPILED FROM VARIOUS SOURCES AND SHOULD BE VERIFIED PRIOR TO USE.
 LOCATIONS SHOWN ARE APPROXIMATE ONLY AND SHOULD BE VERIFIED IN THE FIELD PRIOR TO WORK COMMENCING.

Table of Revisions


Number	Revision	Date	By
0.	Revised	Sept./2003	
	Revised	Oct. 2003	WR/JC
	Revised	June 2004	WR/JC
	Revised	June 2005	WR/JC
	Revised	June 2007	WR
	Added S-1944	Feb. 2013	MLR
	Added S-1944 As-Built	Sep. 2015	MLR



The Corporation
 of the
 City of Windsor
 Engineering – Infrastructure & Geomatics



SEWER ATLAS

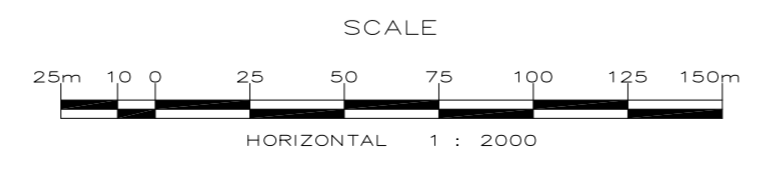

<ul style="list-style-type: none"> SANITARY SEWER STORM SEWER COMBINED SEWER PRIVATE SEWER SANITARY PROPOSED OR AS BUILT INFO STORM CULVERTS, CATCH BASINS AND OUTLETS GAS LINE STEAM LINE HYDRO ONE R.O.W ASSESSMENT LOT 	<ul style="list-style-type: none"> Manhole Location Manhole Number North Invert South Invert East Invert West Invert Top Elevation 	<ul style="list-style-type: none"> Typical Dual Manhole Manhole Number North Invert South Invert East Invert West Invert Top Elevation Sanitary Storm Construction Dwg Number
--	---	---

R7	S7	T7
R8	S8	T8
R9	S9	T9