
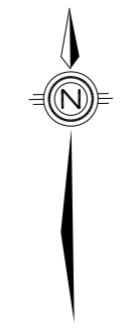


NOTE:
 THE INFORMATION ON THIS PLAN IS COMPILED FROM VARIOUS SOURCES AND SHOULD BE VERIFIED PRIOR TO USE.
 LOCATIONS SHOWN ARE APPROXIMATE ONLY AND SHOULD BE VERIFIED IN THE FIELD PRIOR TO WORK COMMENCING.

Table of Revisions

Number	Revision	Date	By
0.	Revised	Sept/2003	WR/JC
	Revised	Oct. 2003	WR/JC
	Revised	June 2004	WR/JC
	Revised	June 2005	WR/JC
	Revised	June 2007	WR
	Added S-1888 - Proposed	Dec 2009	MLR
	Added S-1888 As-built	July 2011	MLR

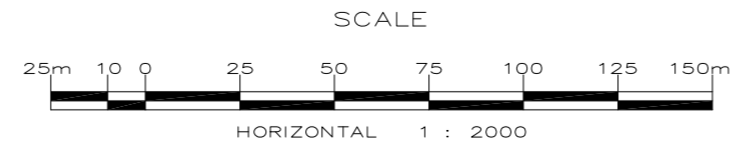

Legend for Sewer Lines and Manholes:

- SANITARY SEWER (Red dashed line)
- STORM SEWER (Blue dashed line)
- COMBINED SEWER (Green dashed line)
- PRIVATE SEWER (Purple dashed line)
- SANITARY PROPOSED OR AS BUILT INFO N/A (Red solid line)
- STORM (Blue solid line)
- CULVERTS, CATCH BASINS AND OUTLETS (Star symbol)
- GAS LINE (Orange solid line)
- STEAM LINE (Yellow solid line)
- HYDRO ONE (Light blue solid line)
- R.O.W. (Black solid line)
- ASSESSMENT LOT (Black dashed line)
- HERB GRAY PKWY LIMITS (Yellow dashed line)

Manhole Location Legend:

- Type: S=Sanitary, Re=Storm, C=Combined
- Manhole Number: 7R00000
- North Invert: N/A
- South Invert: N/A
- East Invert: 190.00
- West Invert: 190.00
- Top Elevation: 190.00

Typical Dual Manhole Legend:

- Type: S=Sanitary, Re=Storm, C=Combined
- Manhole Number: 7R00000
- North Invert: N/A
- South Invert: N/A
- East Invert: 190.00
- West Invert: 190.00
- Top Elevation: 190.00

Other Symbols:

- 100.85m 1200mm CP (Green dashed line)
- S-1000 CONSTRUCTION DWG NUMBER (Black dashed line)

R8	S8	T8
R9	S9	T9
R10	S10	T10