



NOTE:  
 THE INFORMATION ON THIS PLAN IS COMPILED FROM VARIOUS SOURCES AND SHOULD BE VERIFIED PRIOR TO USE.  
 LOCATIONS SHOWN ARE APPROXIMATE ONLY AND SHOULD BE VERIFIED IN THE FIELD PRIOR TO WORK COMMENCING.

Table of Revisions


T9			
Number	Revision	Date	By
0.	Revised	Sept./2003	
	Revised	Oct. 2003	WR/JC
	Revised	June 2004	WR/JC
	Revised	June 2005	WR/JC
	Revised	June 2007	WR
	Added S-1893 Proposed	Mar 2010	MLR
	Added S-1902 As-built	Apr 2011	WR



The Corporation  
 of the  
 City of Windsor  
 Engineering – Infrastructure & Geomatics



# SEWER ATLAS

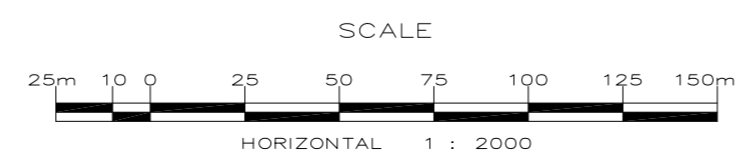

SANITARY SEWER  
 STORM SEWER  
 COMBINED SEWER  
 PRIVATE SEWER  
 SANITARY PROPOSED OR AS BUILT INFO N/A  
 STORM  
 GAS LINE  
 STEAM LINE  
 HYDRO ONE  
 R.O.W  
 ASSESSMENT LOT  
 HERB GRAY PKWY LIMITS

Type  
 S-Sanitary  
 R-Storm  
 C-Combined  
 Manhole Location  
 700000 Manhole Number  
 N/A North Invert  
 N/A South Invert  
 190.00 East Invert  
 190.00 West Invert  
 Top Elevation  
 100.85m 1200mm CP  
 Pipe Length Pipe Size Pipe Material  
 Type  
 Typical Dual Manhole  
 700000 Manhole Number  
 N/A North Invert  
 N/A South Invert  
 190.00 East Invert  
 190.00 West Invert  
 Top Elevation  
 Storm Sanitary  
 [S-1000] CONSTRUCTION DWG NUMBER

S8	T8	U8
S9	<b>T9</b>	U9
S10	T10	U10