



NOTE:  
 THE INFORMATION ON THIS PLAN IS COMPILED FROM VARIOUS SOURCES AND SHOULD BE VERIFIED PRIOR TO USE.  
 LOCATIONS SHOWN ARE APPROXIMATE ONLY AND SHOULD BE VERIFIED IN THE FIELD PRIOR TO WORK COMMENCING.

Table of Revisions



H14			
Number	Revision	Date	By
0.	Revised	01-04-19	
	Revised	03-04-14	
	Revised	Oct. 2003	WR/JC
	Revised	June 2004	WR/JC
	Revised	June 2005	WR/JC
	Revised	June 2007	WR



The Corporation  
 of the  
 City of Windsor  
 Engineering – Infrastructure & Geomatics



# SEWER ATLAS

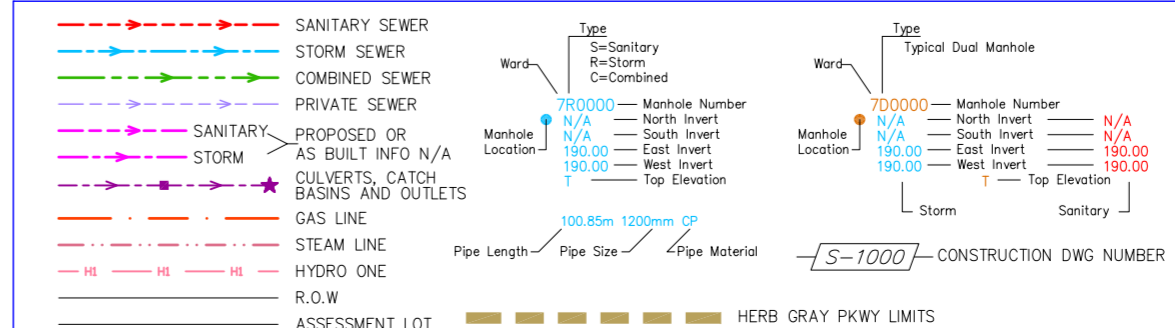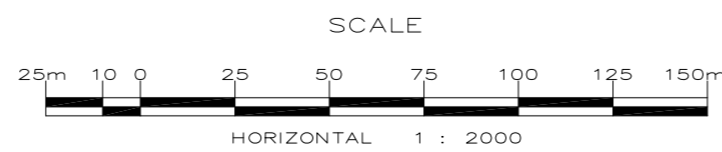

G13	H13	I13
G14	<b>H14</b>	I14
G15	H15	I15