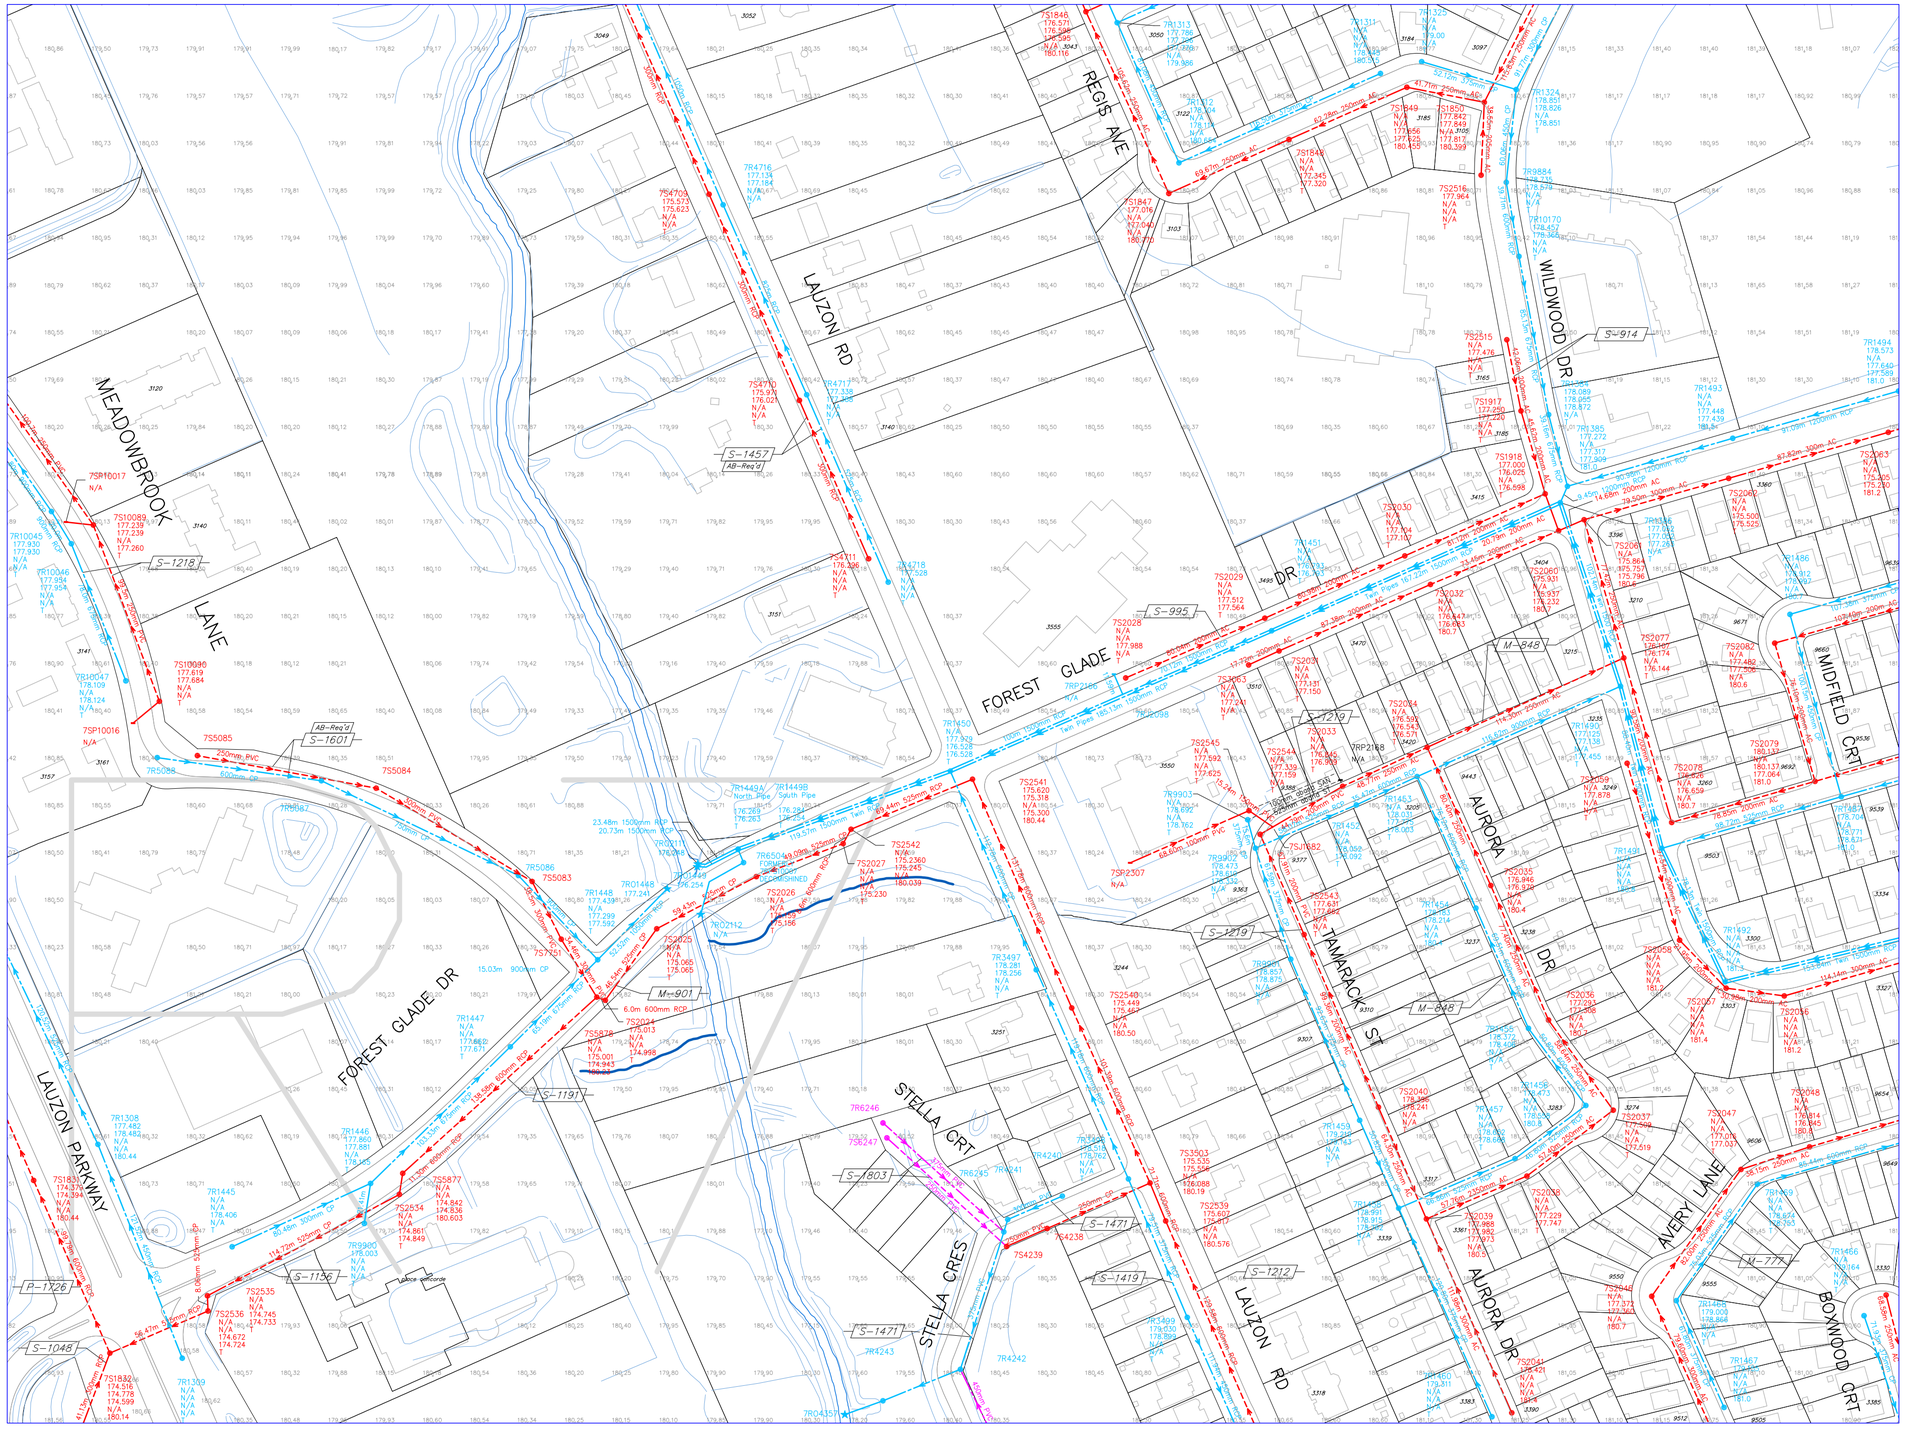

The Corporation of the City of Windsor

Engineering – Infrastructure & Geomatics

GEOMATICS ENGINEERING DEPARTMENT CITY OF WINDSOR

SEWER ATLAS

SCALE

25m 10 0 25 50 75 100 125 150m

HORIZONTAL 1 : 2000

SANITARY SEWER
STORM SEWER
COMBINED SEWER
PRIVATE SEWER
PROPOSED OR AS BUILT INFO N/A
SANITARY
STORM
CULVERTS, CATCH BASINS AND OUTLETS
GAS LINE
STEAM LINE
HYDRO ONE
R.O.W
ASSESSMENT LOT

Type S=Sanitary R=Storm C=Combined
Manhole Location — Ward — 7R0000 Manhole Number — N/A North Invert — N/A South Invert — 190.00 East Invert — 190.00 West Invert — T Top Elevation
Pipe Length — 100.85m — Pipe Size — 1200mm CP — Pipe Material
Type Typical Dual Manhole
Manhole Location — Ward — 7D0000 Manhole Number — N/A North Invert — N/A South Invert — 190.00 East Invert — 190.00 West Invert — T Top Elevation — Storm — Sanitary
S-1000 CONSTRUCTION DWG NUMBER
HERB GRAY PKWY LIMITS

NOTE:
THE INFORMATION ON THIS PLAN IS COMPILED FROM VARIOUS SOURCES AND SHOULD BE VERIFIED PRIOR TO USE.

LOCATIONS SHOWN ARE APPROXIMATE ONLY AND SHOULD BE VERIFIED IN THE FIELD PRIOR TO WORK COMMENCING.

Table of Revisions

R7

Number	Revision	Date	By
0.	Revised	Sept/2003	
	Revised	Oct. 2003	WR/JC
	Revised	June 2004	WR/JC
	Revised	June 2005	WR/JC
	Revised	June 2007	WR
	Revised To Show Edge of Pavement 2006	July 2007	WR
	Revised	Dec. 2017	NS

Q6	R6	S6
Q7	**R7**	S7
Q8	R8	S8