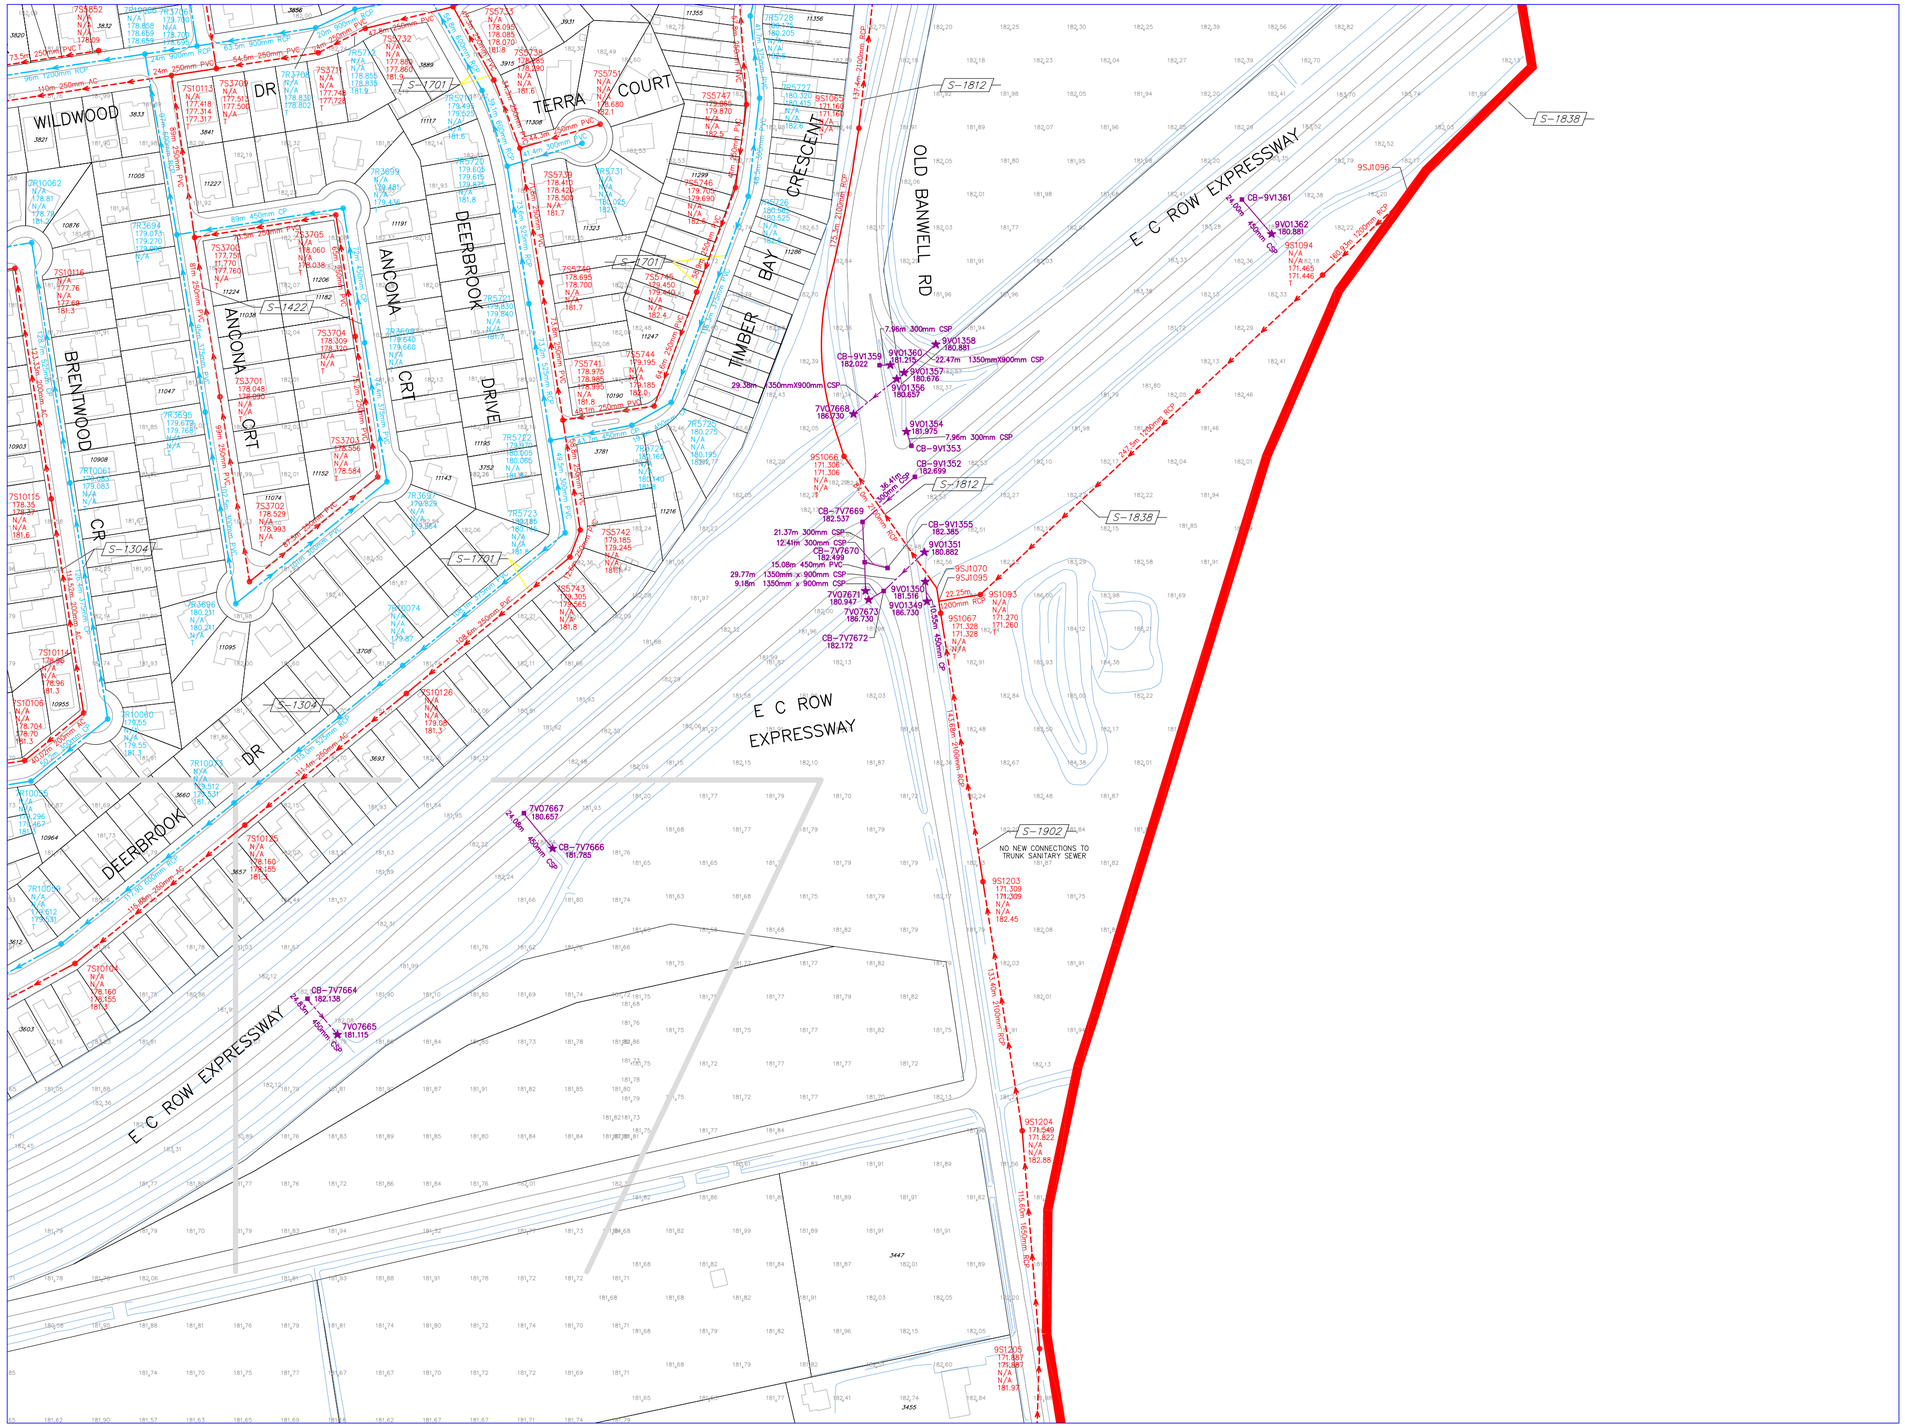

The Corporation of the City of Windsor

Engineering – Infrastructure & Geomatics

GEOMATICS ENGINEERING DEPARTMENT CITY OF WINDSOR

SEWER ATLAS

SCALE

25m 10 0 25 50 75 100 125 150m

HORIZONTAL 1 : 2000

SANITARY SEWER
STORM SEWER
COMBINED SEWER
PRIVATE SEWER
SANITARY PROPOSED OR AS BUILT INFO N/A
STORM
CULVERTS, CATCH BASINS AND OUTLETS
GAS LINE
STEAM LINE
HYDRO ONE
R.O.W
ASSESSMENT LOT
HERB GRAY PKWY LIMITS

Type: S=Sanitary R=Storm C=Combined
Ward
Manhole Location
7R00000 Manhole Number
N/A North Invert
N/A South Invert
190.00 East Invert
190.00 West Invert
T Top Elevation
Pipe Length 100.85m
Pipe Size 1200mm
Pipe Material CP

Type: Typical Dual Manhole
Ward
Manhole Location
7D00000 Manhole Number
N/A North Invert
N/A South Invert
190.00 East Invert
190.00 West Invert
T Top Elevation
Storm
Sanitary
N/A
N/A
190.00
190.00

S-1000 CONSTRUCTION DWG NUMBER

NOTE:
THE INFORMATION ON THIS PLAN IS COMPILED FROM VARIOUS SOURCES AND SHOULD BE VERIFIED PRIOR TO USE.

LOCATIONS SHOWN ARE APPROXIMATE ONLY AND SHOULD BE VERIFIED IN THE FIELD PRIOR TO WORK COMMENCING.

Table of Revisions

T7

Number	Revision	Date	By
0.	Revised	Oct. 2003	WR/JC
	Revised	June 2004	WR/JC
	Revised	June 2005	WR/JC
	Revised	June 2007	WR
	Revised To Show Edge of Pavement 2006	July 2007	WR
	Added As-builts for Banwell Sanitary Sewer	Nov 2007	MR
	Revised	Oct 2008	JM
	Added S-1902 As-built	Apr 2011	MR

S6	T6	U6
S7	T7	U7
S8	T8	U8