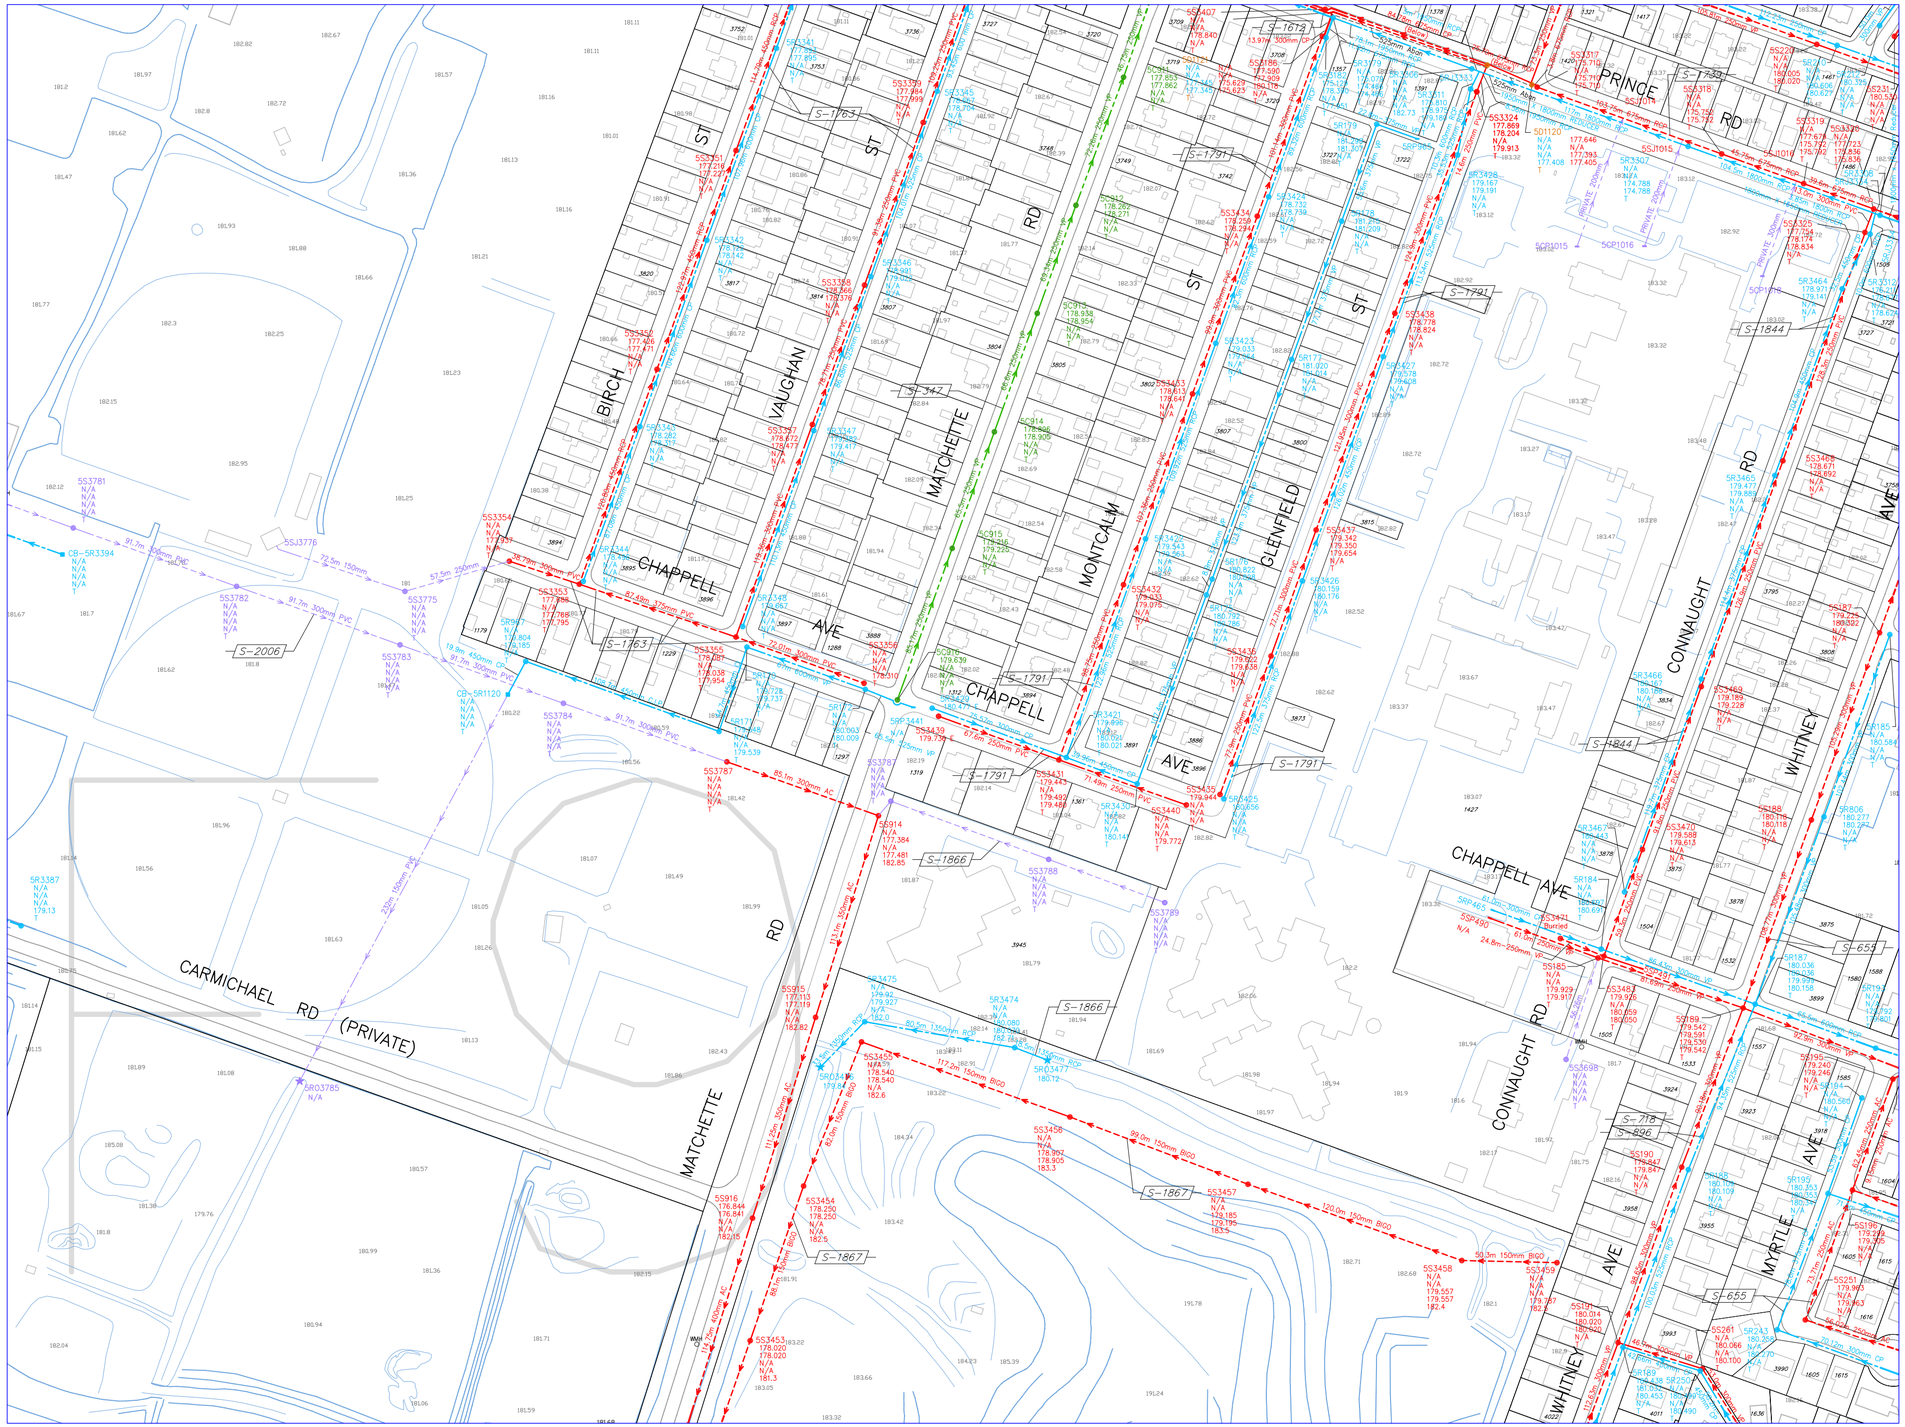

NOTE:
THE INFORMATION ON THIS PLAN IS COMPILED FROM VARIOUS SOURCES AND SHOULD BE VERIFIED PRIOR TO USE.

LOCATIONS SHOWN ARE APPROXIMATE ONLY AND SHOULD BE VERIFIED IN THE FIELD PRIOR TO WORK COMMENCING.

Table of Revisions

F9			
Number	Revision	Date	By
0.	Revised	01-04-19	
	Revised	03-04-14	
	Revised	Oct. 2003	WR/JC
	Revised	June 2004	WR/JC
	Revised	June 2005	WR/JC
	Revised	June 2007	WR
	Added S-1866 and S-1867 As-built	Jan 2008	MLR
	Added S-1791 and S-1844 As-built	Jun 2014	MLR

E8	F8	G8
E9	**F9**	G9
E10	F10	G10

The Corporation of the City of Windsor

Engineering – Infrastructure & Geomatics

GEOMATICS ENGINEERING DEPARTMENT CITY OF WINDSOR

SEWER ATLAS

SCALE

25m 10 0 25 50 75 100 125 150m

HORIZONTAL 1 : 2000

SANITARY SEWER
STORM SEWER
COMBINED SEWER
PRIVATE SEWER
PROPOSED OR AS BUILT INFO N/A
SANITARY
STORM
GAS LINE
STEAM LINE
HYDRO ONE
R.O.W
ASSESSMENT LOT
HERB GRAY PKWY LIMITS

Type: S=Sanitary R=Storm C=Combined
Ward
Manhole Location
7R0000 Manhole Number
N/A North Invert
N/A South Invert
190.00 East Invert
190.00 West Invert
Top Elevation
100.85m 1200mm CP
Pipe Length
Pipe Size
Pipe Material

Type: Typical Dual Manhole
Ward
700000 Manhole Number
N/A North Invert N/A
N/A South Invert N/A
190.00 East Invert 190.00
190.00 West Invert 190.00
Top Elevation
Storm
Sanitary
S-1000 CONSTRUCTION DWG NUMBER