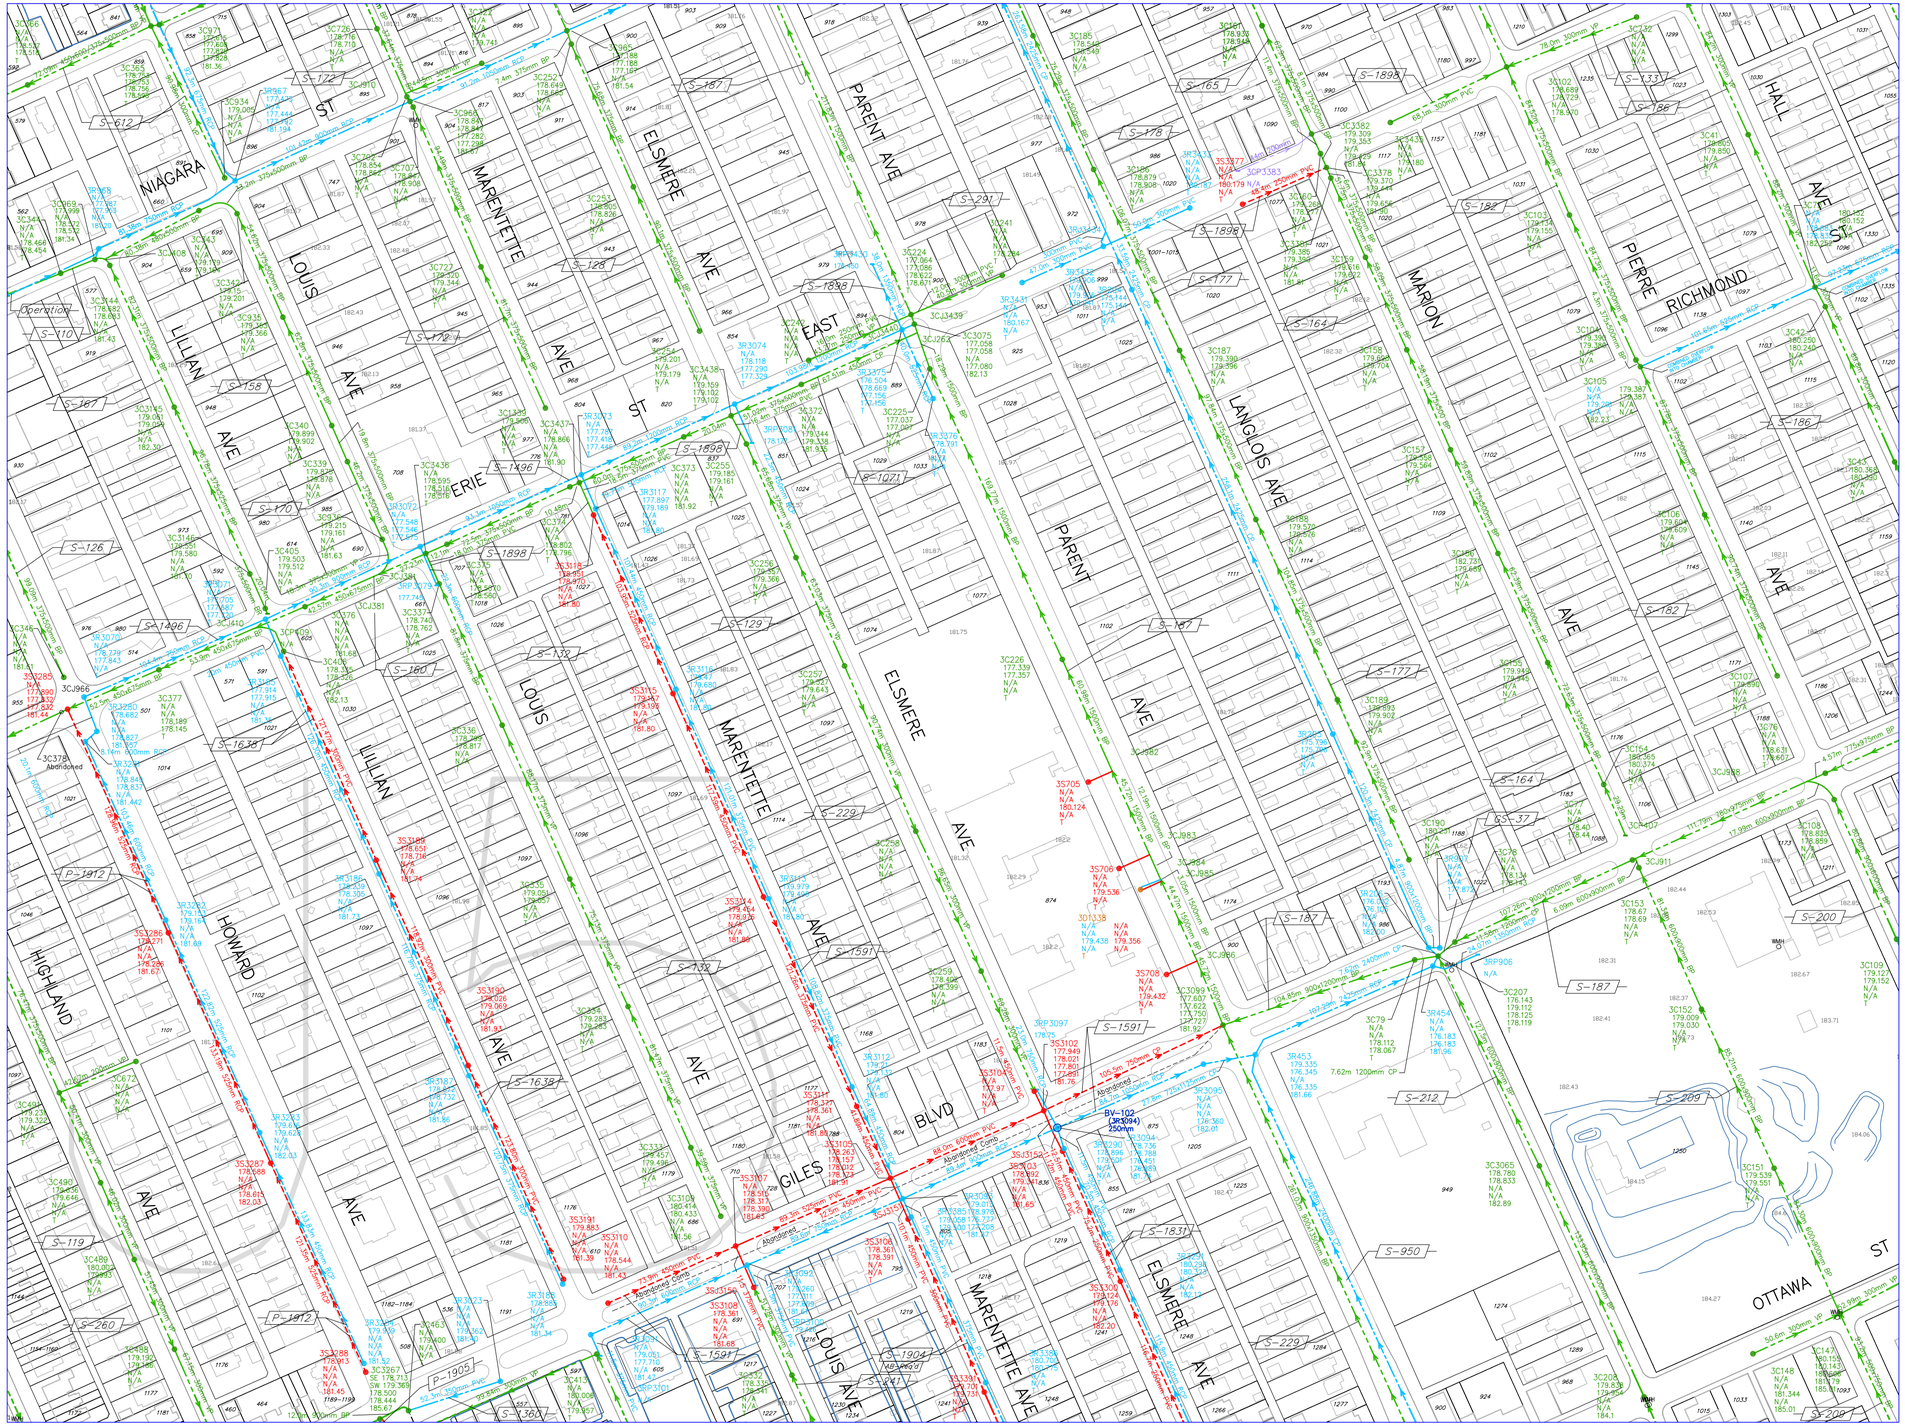

The Corporation of the City of Windsor

Engineering – Infrastructure & Geomatics

GEOMATICS ENGINEERING DEPARTMENT CITY OF WINDSOR

SEWER ATLAS

SCALE

25m 10 0 25 50 75 100 125 150m

HORIZONTAL 1 : 2000

SANITARY SEWER
STORM SEWER
COMBINED SEWER
PRIVATE SEWER
SANITARY — PROPOSED OR AS BUILT INFO N/A
STORM
GAS LINE
STEAM LINE
HYDRO ONE
R.O.W
ASSESSMENT LOT
HERB GRAY PKWY LIMITS

Type
S=Sanitary
R=Storm
C=Combined
Ward
7R0000 Manhole Number
Manhole Location
N/A North Invert
190.00 South Invert
190.00 East Invert
West Invert
Top Elevation
100.85m 1200mm CP
Pipe Length Pipe Size Pipe Material

Type
Typical Dual Manhole
Ward
7D0000 Manhole Number
Manhole Location
N/A North Invert N/A
N/A South Invert 190.00
190.00 East Invert 190.00
190.00 West Invert 190.00
Top Elevation
Storm Sanitary

S-1000 CONSTRUCTION DWG NUMBER

NOTE:
THE INFORMATION ON THIS PLAN IS COMPILED FROM VARIOUS SOURCES AND SHOULD BE VERIFIED PRIOR TO USE.

LOCATIONS SHOWN ARE APPROXIMATE ONLY AND SHOULD BE VERIFIED IN THE FIELD PRIOR TO WORK COMMENCING.

Table of Revisions

J5

Number	Revision	Date	By
0.	Revised	Oct. 2003	WR/JC
	Revised	June 2004	WR/JC
	Revised	June 2005	WR/JC
	Revised	June 2007	WR
	Revised	Oct. 2008	JM
	Added S-1831 Proposed	Dec. 2008	MR
	Added S-1898 As-builts	Dec. 2012	MR
	Added S-1918	Aug. 2013	MLR

I4	J4	K4
I5	**J5**	K5
I6	J6	K6