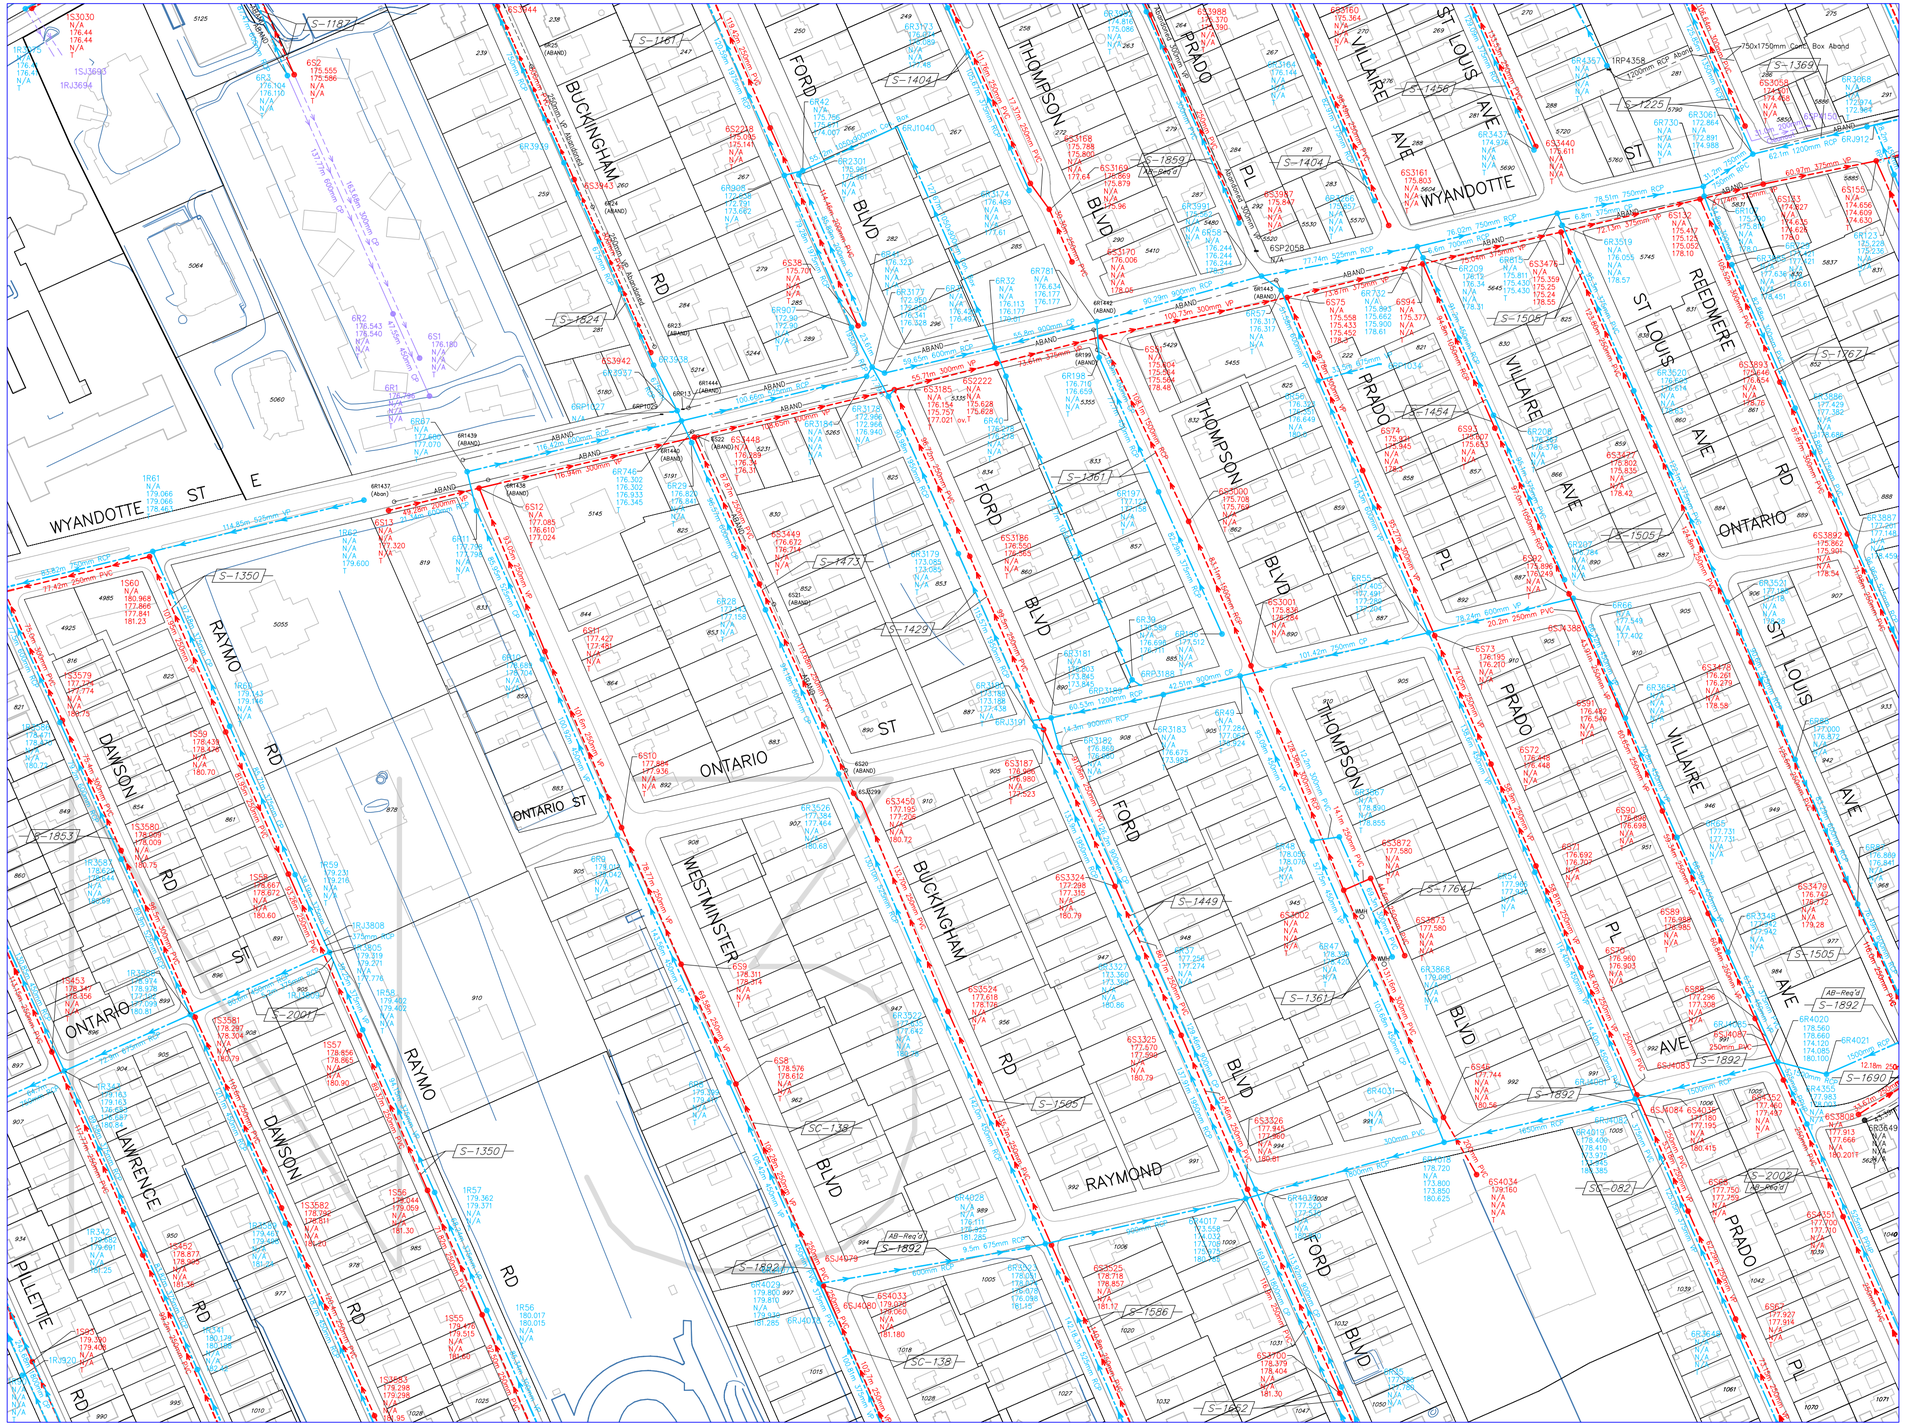

The Corporation of the City of Windsor

Engineering – Infrastructure & Geomatics

GEOMATICS ENGINEERING DEPARTMENT CITY OF WINDSOR

SEWER ATLAS

SCALE

25m 10 0 25 50 75 100 125 150m

HORIZONTAL 1 : 2000

SANITARY SEWER
STORM SEWER
COMBINED SEWER
PRIVATE SEWER
SANITARY
STORM
PROPOSED OR AS BUILT INFO N/A
GAS LINE
STEAM LINE
HYDRO ONE
R.O.W
ASSESSMENT LOT
HERB GRAY PKWY LIMITS

Type
S=Sanitary
R=Storm
C=Combined
Ward
Manhole Location
700000 Manhole Number
N/A North Invert
N/A South Invert
190.00 East Invert
190.00 West Invert
T Top Elevation
100.85m 1200mm CP
Pipe Length
Pipe Size
Pipe Material

Type
Typical Dual Manhole
Ward
Manhole Location
700000 Manhole Number
N/A North Invert
N/A South Invert
190.00 East Invert
190.00 West Invert
T Top Elevation
Storm
Sanitary
S-1000 CONSTRUCTION DWG NUMBER

NOTE:
THE INFORMATION ON THIS PLAN IS COMPILED FROM VARIOUS SOURCES AND SHOULD BE VERIFIED PRIOR TO USE.

LOCATIONS SHOWN ARE APPROXIMATE ONLY AND SHOULD BE VERIFIED IN THE FIELD PRIOR TO WORK COMMENCING.

Table of Revisions

N3

Number	Revision	Date	By
0.	Revised	Oct. 2003	WR/JC
	Revised	June 2004	WR/JC
	Revised	June 2005	WR/JC
	Revised	June 2007	WR
	Added S-1892 Proposed	Mar 2010	MLR
	Added S-1853 As-Built	Feb 2015	MLR
	Added S-2001	Sep 2015	MLR
	Added S-2002	Oct 2015	MLR
	Added S-2001 As Built	Jun 2016	MLR

M2	N2	02
M3	**N3**	03
M4	N4	04