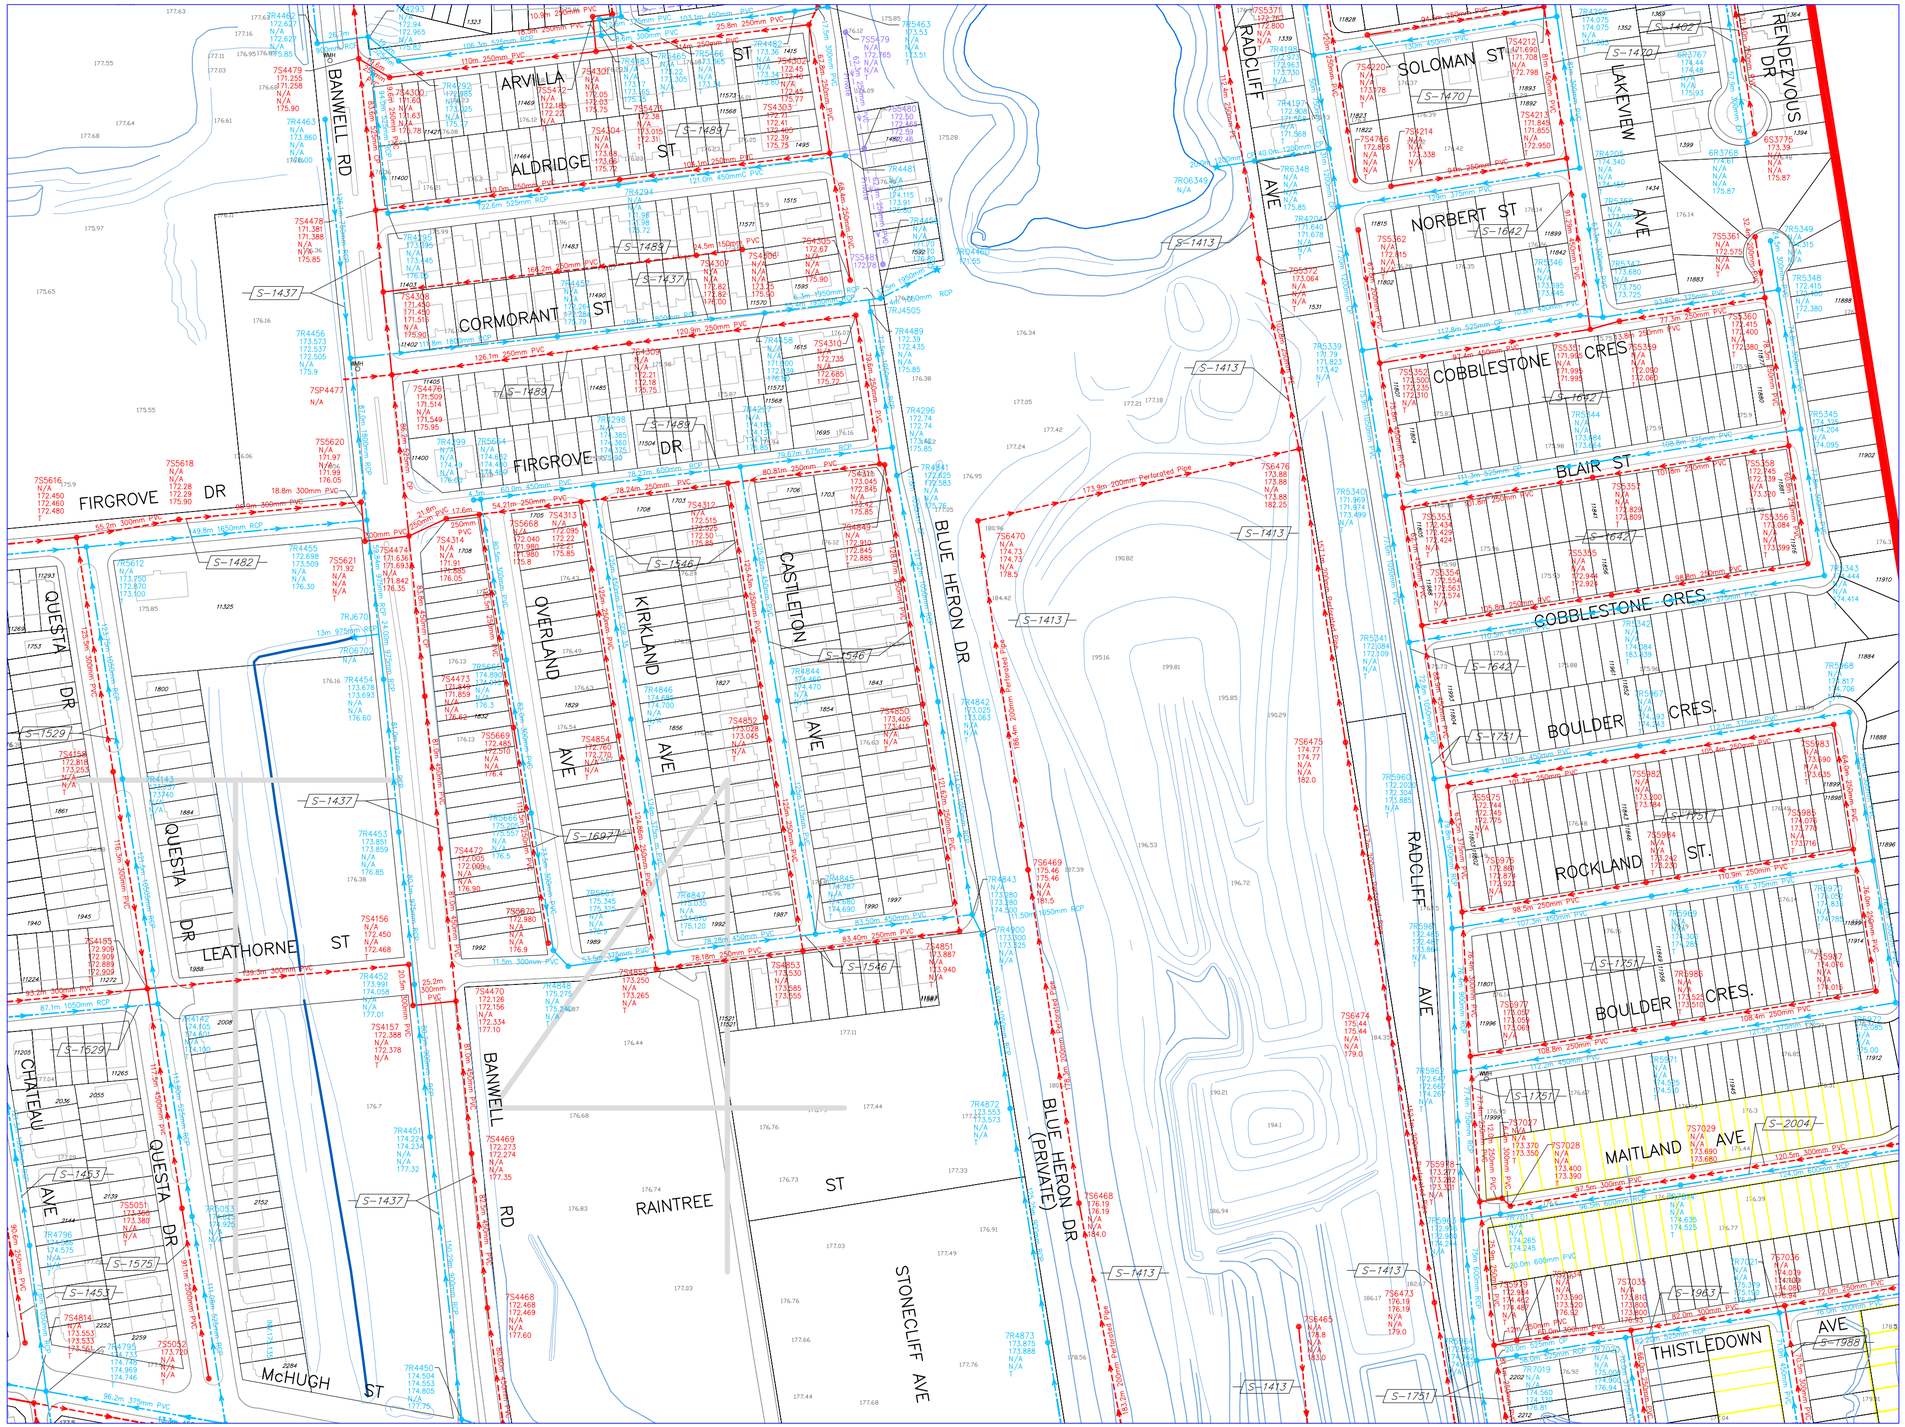

NOTE:
THE INFORMATION ON THIS PLAN IS COMPILED FROM VARIOUS SOURCES AND SHOULD BE VERIFIED PRIOR TO USE.

LOCATIONS SHOWN ARE APPROXIMATE ONLY AND SHOULD BE VERIFIED IN THE FIELD PRIOR TO WORK COMMENCING.

Table of Revisions

T4			
Number	Revision	Date	By
0.	Revised	June 2005	WR/JC
	Revised	June 2007	WR
	Revised To Show Edge of Pavement 2006	July 2007	WR
	Revised to show asbuilt S-1413	April 2008	PJJ
	Revised	Oct 2008	JM
	Added S-1963 As-Built	Jan 2014	MLR
	Added S-1988 As-Built	Nov 2014	MLR
	Added S-2004 As-Built	Jul 2015	MLR

S3	T3	U3
S4	**T4**	U4
S5	T5	U5

The Corporation of the City of Windsor

Engineering – Infrastructure & Geomatics

GEOMATICS ENGINEERING DEPARTMENT CITY OF WINDSOR

SEWER ATLAS

SCALE

25m 10 0 25 50 75 100 125 150m

HORIZONTAL 1 : 2000

- SANITARY SEWER
- STORM SEWER
- COMBINED SEWER
- PRIVATE SEWER
- SANITARY — PROPOSED OR AS BUILT INFO N/A
- STORM
- GAS LINE
- STEAM LINE
- HYDRO ONE
- R.O.W
- ASSESSMENT LOT
- HERB GRAY PKWY LIMITS

Type: S=Sanitary, R=Storm, C=Combined
Ward — Manhole Location — 7R00000 Manhole Number — N/A North Invert — N/A South Invert — 190.00 East Invert — 190.00 West Invert — Top Elevation
Pipe Length — 100.85m 1200mm CP — Pipe Size — Pipe Material

Type: Typical Dual Manhole
Ward — Manhole Location — 700000 Manhole Number — N/A North Invert — N/A South Invert — 190.00 East Invert — 190.00 West Invert — Top Elevation
Storm — Sanitary

S-1000 CONSTRUCTION DWG NUMBER