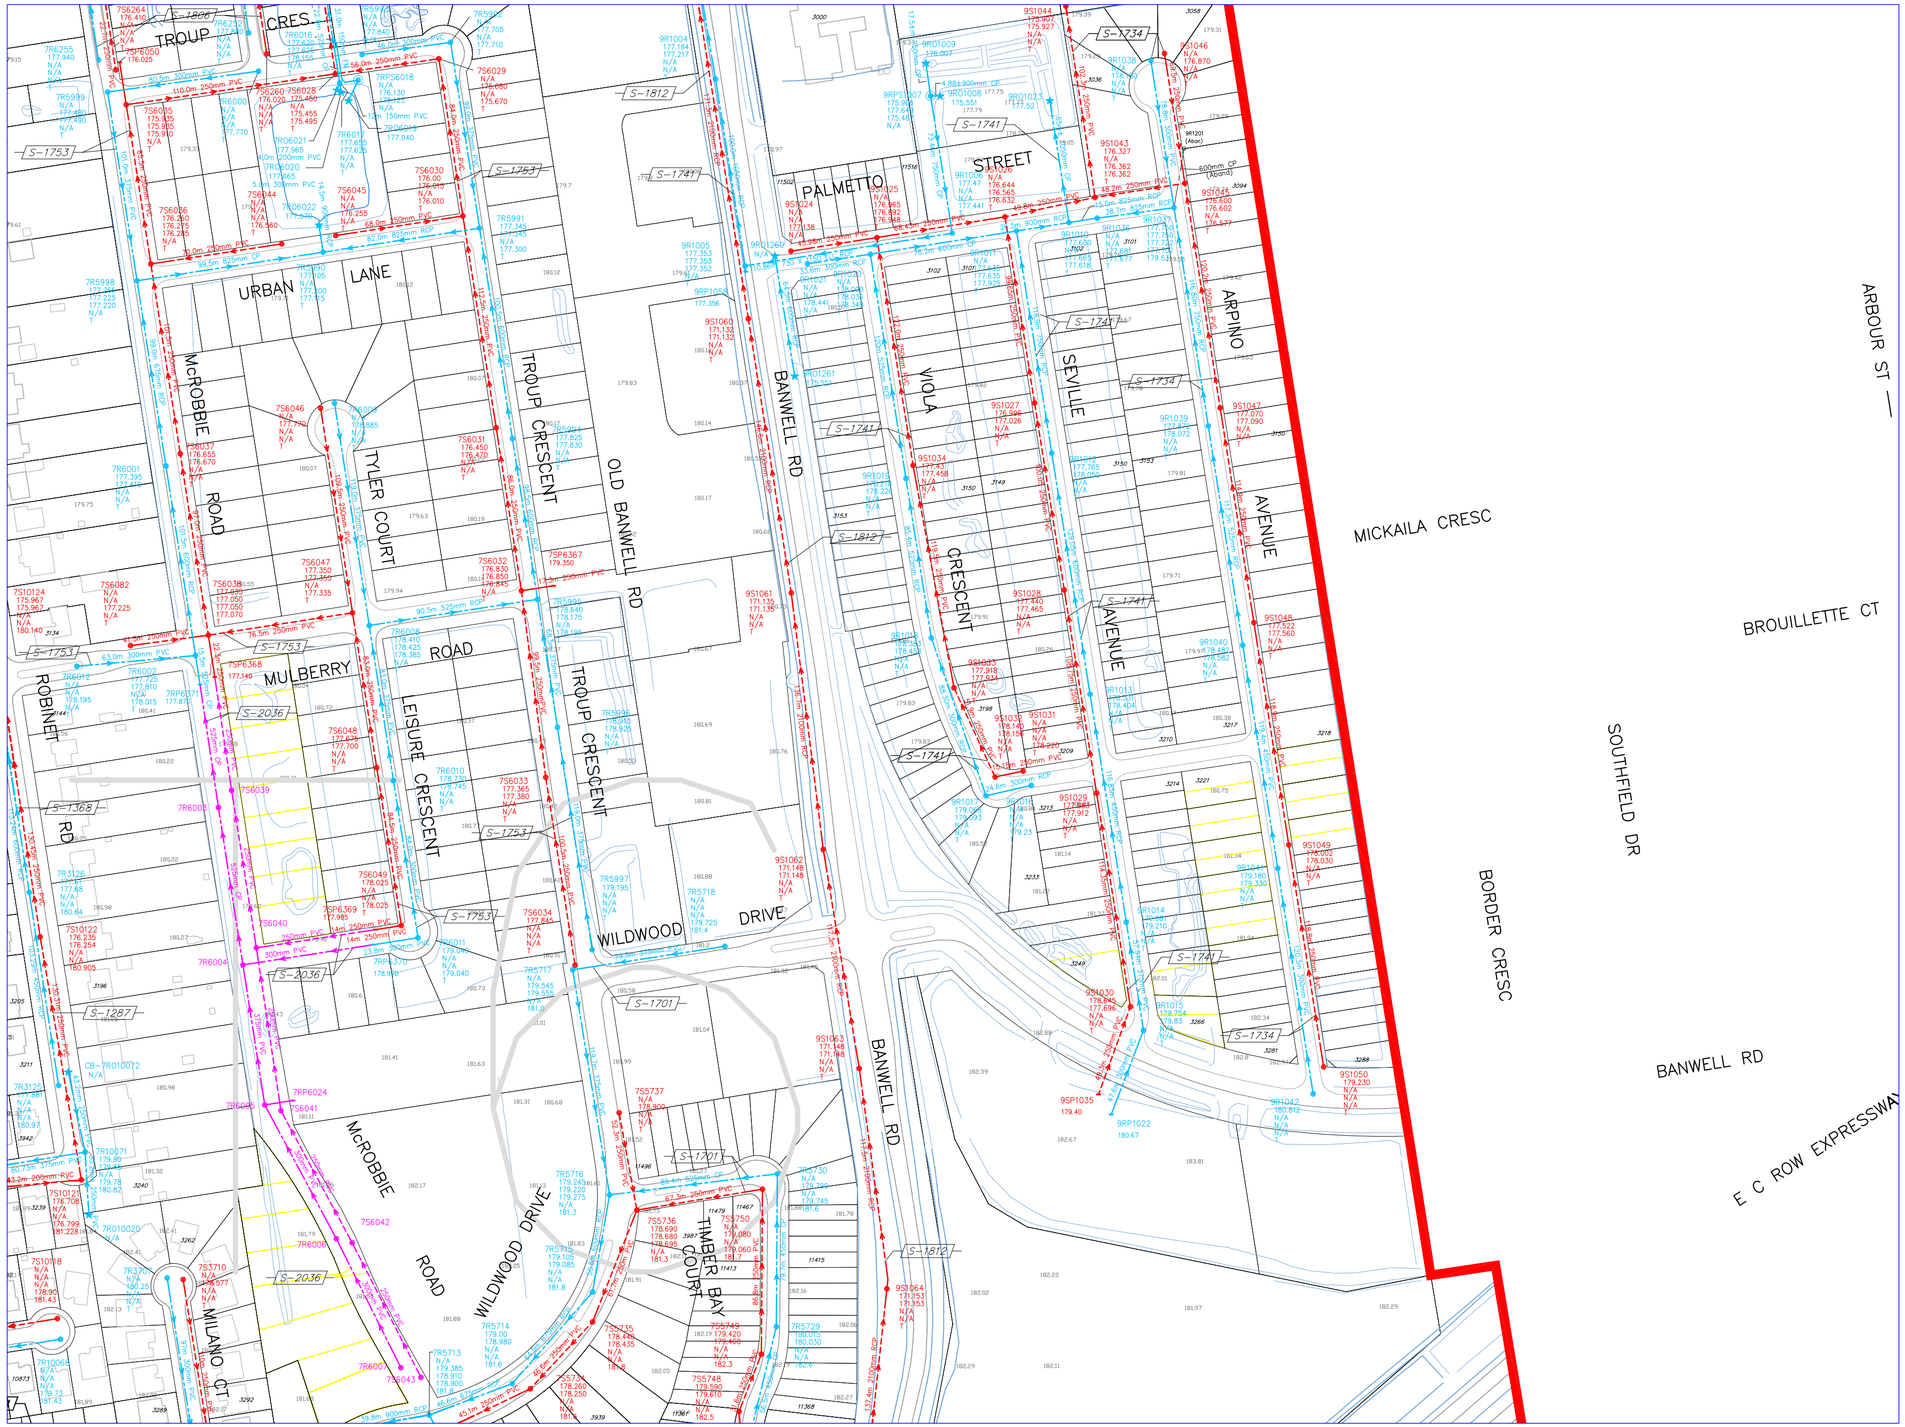

NOTE:
THE INFORMATION ON THIS PLAN IS COMPILED FROM VARIOUS SOURCES AND SHOULD BE VERIFIED PRIOR TO USE.

LOCATIONS SHOWN ARE APPROXIMATE ONLY AND SHOULD BE VERIFIED IN THE FIELD PRIOR TO WORK COMMENCING.

Table of Revisions

T6			
Number	Revision	Date	By
0.	Revised	Sept/2003	
	Revised	Oct. 2003	WR/JC
	Revised	June 2004	WR/JC
	Revised	June 2005	WR/JC
	Revised	June 2007	WR
	Revised To Show Edge of Pavement 2006	July 2007	WR
	Added As-builts for Banwell Sanitary Sewer	Nov 2007	MR

The Corporation of the City of Windsor

Engineering – Infrastructure & Geomatics

GEOMATICS ENGINEERING DEPARTMENT CITY OF WINDSOR

SEWER ATLAS

SCALE

25m 10 0 25 50 75 100 125 150m

HORIZONTAL 1 : 2000

SANITARY SEWER
STORM SEWER
COMBINED SEWER
PRIVATE SEWER
PROPOSED OR AS BUILT INFO N/A
SANITARY
STORM
GAS LINE
STEAM LINE
HYDRO ONE
R.O.W
ASSESSMENT LOT
HERB GRAY PKWY LIMITS

Type
S=Sanitary
R=Storm
C=Combined
Ward
Manhole Location
7R0000 Manhole Number
N/A North Invert
N/A South Invert
190.00 East Invert
190.00 West Invert
T Top Elevation
Storm
Sanitary
100.85m 1200mm CP
Pipe Length
Pipe Size
Pipe Material

Type
Typical Dual Manhole
Ward
Manhole Location
7D0000 Manhole Number
N/A North Invert N/A
N/A South Invert 190.00
190.00 East Invert 190.00
190.00 West Invert
T Top Elevation
Storm
Sanitary
S-1000 CONSTRUCTION DWG NUMBER

S5	T5	U5
S6	**T6**	U6
S7	T7	U7